Authorization to Construct PIN#4636-44-6424

IREDELL COUNTY HEALTH DEPARTMENT

STATESVILLE 704-878-5305 MOORESVILLE 704-664-5281

IMPROVEMENT PERMIT / ~~CERTIFICATE OF COMPLETION~~ / OPERATION PERMIT / EXISTING SYSTEM INSPECTION

PROPERTY DESCRIPTION NO. 24987 DATE 10/28/96 TAX MAP NO. 2K 10 A 235 Watershed: [X] Yes ☐ No

OWNER OR CONTRACTOR Hopkins-Hopkins Const. PHONE: Business 875-0680 Home

ADDRESS PO Box 682 Huntersville, NC. 28078

LOCATION Brawley Sch, TL Statts Rd., TR Fairway Dr. 2nd lot on (R)

SUBDIVISION Fairway Est. BLOCK / SECTION LOT 235 LOT AREA .577 SITE CLASS. PS DESIGN FLOW 360 L.T.A.R. .30

Septic Tank: 1000 Gallons; STB 794 Date 1/29/97

Pump Tank: Gallons; PT Date

Pump Make: Model Serial No.

Nitrification Field: No Fields 1 Square Feet 900* Linear Feet 300*

No Lines 3 Trench Width 36" Max Trench Bottom Depth 36" Gravel Depth SAND

[X] New System ☐ Repair System Type: I, II, (III), IV, V, VI

System Description: *GRAV CH PLASTIC

Repair System Description: 16" PPBS

Maintenance Agreement Required: ☐ Yes [X] No

[X] House/Mod. Home No. Bedrooms 3

☐ Mobile Home No. Bathrooms 2.5

☐ Business No. Employees

☐ Other

☐ Slab [X] Crawl Space ☐ Basement w/plumbing ☐ Basement wo/plumbing


Water Supply: [X] Individual ☐ Community ☐ Public

Comments:

Comments:

INITIAL SITE SKETCH

AS BUILT SKETCH

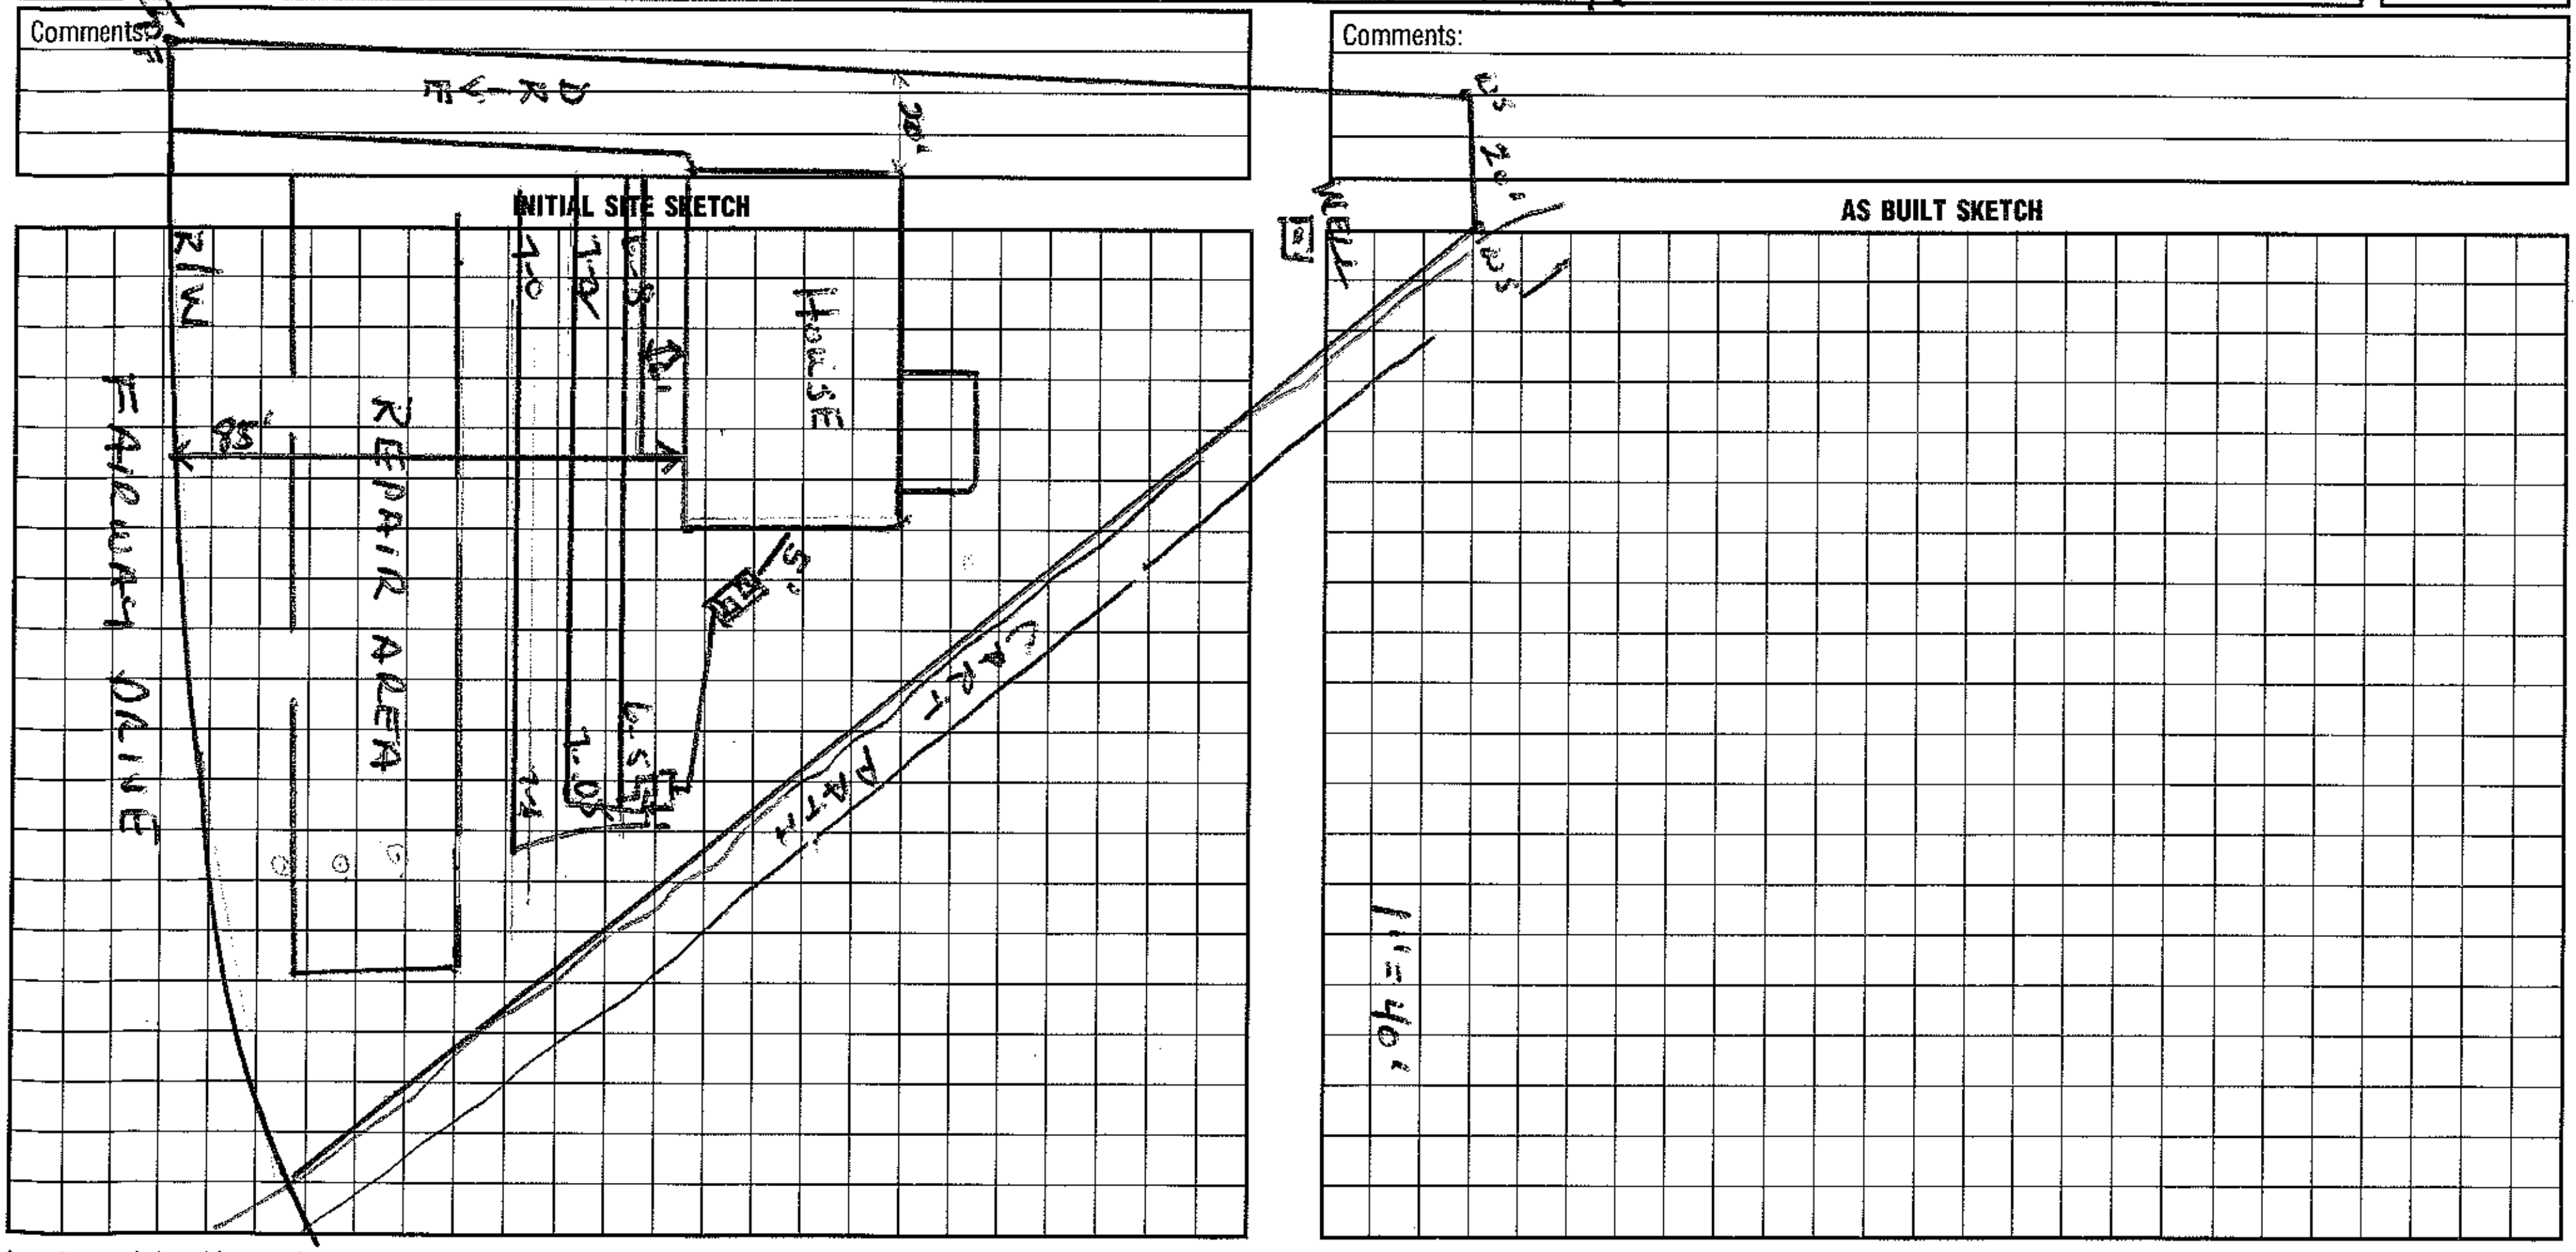

I understand that this permit can be suspended or revoked if any false information is supplied toward securing the permit/any unauthorized changes are made to the site/any unauthorized changes are made in the installation of the system.

Authorization to construct valid 60 months.

Signed: *[signature]

Installed by: Mayhew Septic Service

Improvement Permit by: Wesley Sparks R.S. date 10/28/96

Certificate of Completion by: Wesley Sparks R.S. date 4/3/97

Authorization to Construct (~~Existing System Inspection~~) by: Wesley Sparks R.S. date 10/28/96

Operation Permit by: Wesley Sparks R.S. date 4/3/97

HEALTH DEPT. COPY: WHITE INSPECTION COPY (FINAL): GREEN OWNER COPY (FINAL): YELLOW INSPECTION COPY (INITIAL): PINK OWNER COPY (INITIAL): GOLD