MD 2:00

IREDELL COUNTY HEALTH DEPARTMENT

Statesville Office (704) 878-5305 Mooresville Office (704) 660-3625 PERMIT # 211726

IMPROVEMENT PERMIT / AUTHORIZATION TO CONSTRUCT / OPERATION PERMIT / EXISTING SYSTEM

PIN # 4636-44-7135

APPLICANT: Titan Builders APPLICANT ADDRESS: PO Box 3126, Mooresville NC

SITE ADDRESS: 256 Stutts Rd, Mocksville PHONE: ALT. PHONE:

SITE DIRECTIONS: Brawley Sch Rd, TL on Stutts, TR on Fairway, 2nd Lot on L


SUBDIVISION: Fairway Estates SECTION: — LOT # 215 LOT AREA: 2.01 ac DESIGN FLOW: 480 gpd L.T.A.R.: 0.25

Septic Tank	1000 (gal)	STB	825	Date	4-2-16	☑ New System ☐ Repair ☐ Expansion	System Type: I II (III) IV V VI	☑ Residence	No. Bedrooms	4	Water Supply
Pump Tank	(gal)	PT		Date		System Description:	Gravity 25% Reduction	☐ Business	No. Persons	8	☑ Private
Pump Make		Model		Serial #		Repair System Description:	25% Reduction	☐ Other	No. Employees		☐ Public
# Nitrification Fields	1	# Lines	4	Linear Ft:	480'	Maintenance Agreement Required:	☐ YES ☑ NO	☐ Slab	☑ Crawl Space		☐ Community
Trench Width	36"	Max. Trench Bottom Depth	*36"*	Gravel Depth	N/A	☑ GRAVITY	☐ PRESSURE	☐ Basement w/plumbing		☐ Basement w/o plumbing	


Comments / Conditions: *INSTALL TRENCHES 36" DEEP*

Installed Quick 4 Drainfield Similar to drawing

INITIAL SITE SKETCH

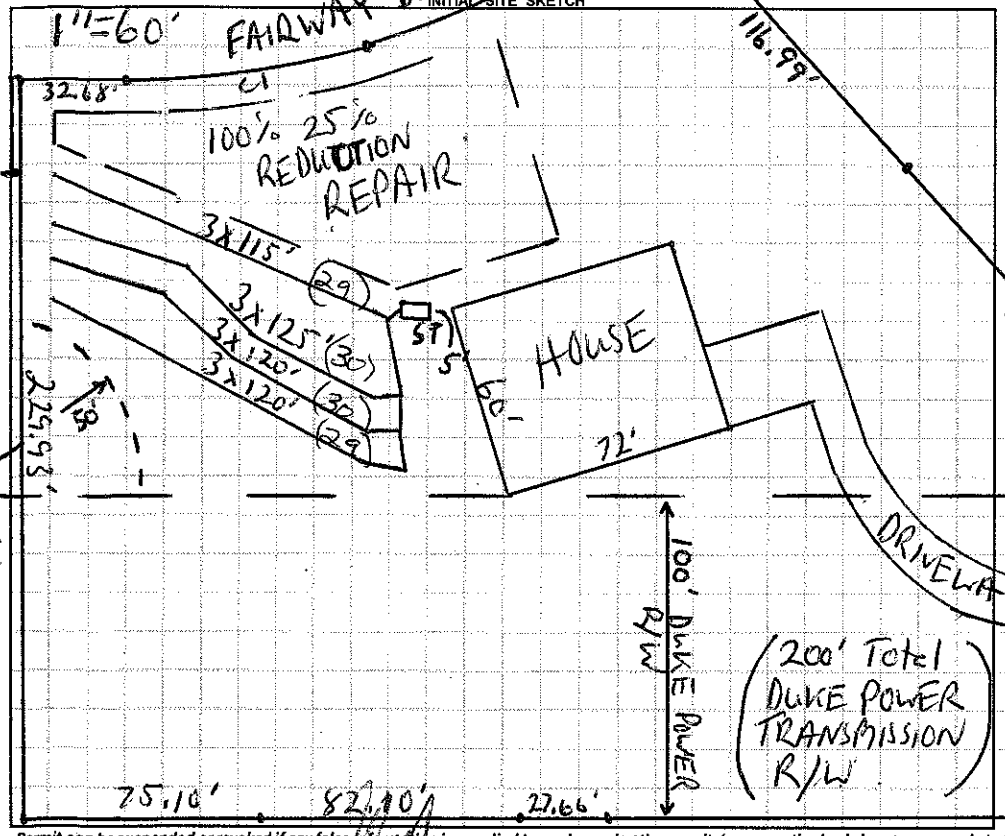

AS BUILT SKETCH

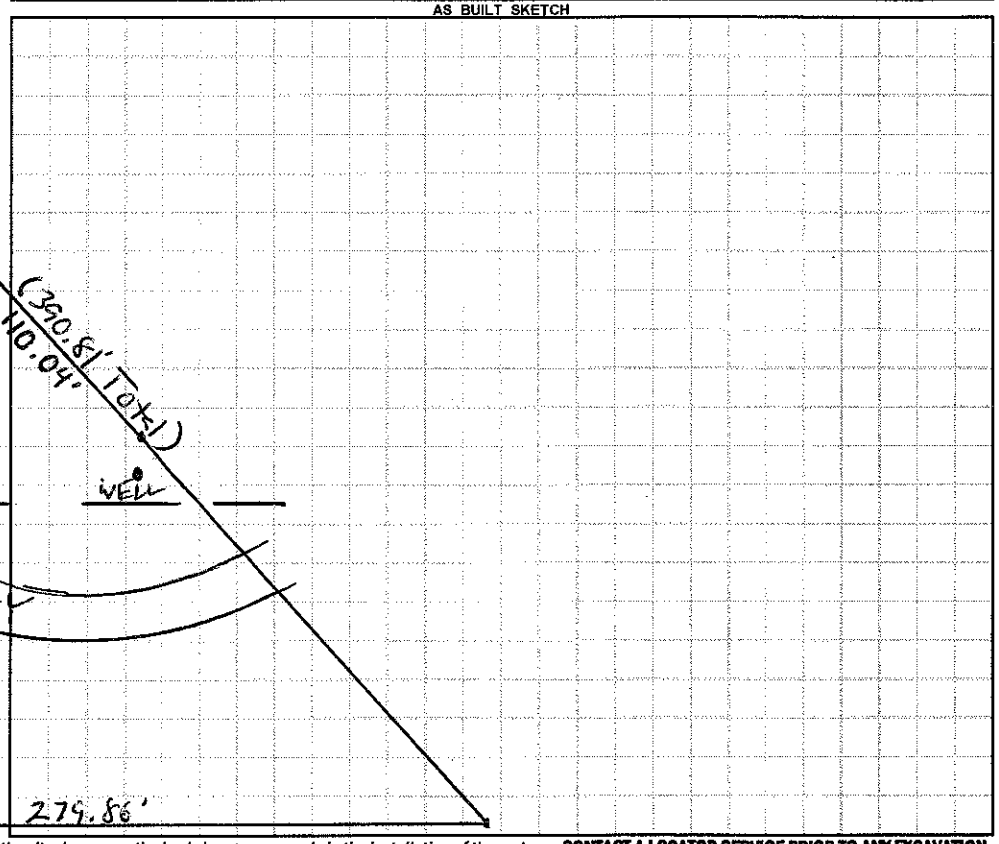

Permit can be suspended or revoked if any false information is supplied toward securing the permit / any unauthorized changes are made to the site / any unauthorized changes are made in the installation of the system. **CONTACT A LOCATOR SERVICE PRIOR TO ANY EXCAVATION**

☐ **IMPROVEMENT PERMIT** *with plat* valid without expiration. ☒ **IMPROVEMENT PERMIT** *with site plan* valid for 60 mos. ☒ **AUTHORIZATION TO CONSTRUCT** valid for period equal to IMPROVEMENT PERMIT--not to exceed 60 mo.

Owner / Applicant Signature: Date: 11/17/2014 Installed by: Rowan Septic

IMPROVEMENT PERMIT by: Date: 5-21-15 OPERATION PERMIT by: Mainer Johnson RS Date: 6/9/16

AUTHORIZATION TO CONSTRUCT by: Date: 5-21-15 Existing System Inspected by: Date:

Health Dept. Copy - WHITE Applicant (Final Approval) - YELLOW Applicant (Conditional Approval) - PINK