IREDELL COUNTY HEALTH DEPARTMENT

STATESVILLE 704-878-5305 $25 4.00 MOORESVILLE 704-664-5281

IMPROVEMENT PERMIT / AUTHORIZATION TO CONSTRUCT / OPERATION PERMIT / EXISTING SYSTEM INSPECTION

PERMIT# 1044/55 PIN# 4636-55-2733 DATE 2/5/02

OWNER OR CONTRACTOR Ryan Laney PHONE: Business Home 704 664 1630

ADDRESS 223 Stutts Rd Mooresville NC 28117

LOCATION Brawley Sch, on Lt before Stutts 1057 Brawley Sch.

SUBDIVISION BLOCK / SECTION LOT LOT AREA 62.78AC SITE CLASS. PS DESIGN FLOW 360 L.T.A.R. 0.3

Septic Tank: 1000 Gallons; STB 1012 Date 1/5/01
Pump Tank: Gallons; PT Date
Pump Make: Model Serial No.
Nitrification Field: No Fields 1 Square Feet 1200 Linear Feet 400
No Lines 5 Trench Width 36" Max Trench Bottom Depth 36" * Gravel Depth 12"

☒ New System ☐ Repair System Type: I, II, III, IV, V, VI
System Description: Gravity Conventional
Repair System Description: Same
Maintenance Agreement Required: ☐ Yes ☒ No

☐ House/Mod. Home No. Bedrooms 3
☒ Mobile Home No. Bathrooms 2
☐ Business No. Employees
☐ Other


☐ Slab ☒ Crawl Space ☐ Basement w/plumbing ☐ Basement wo/plumbing

Water Supply: ☒ Individual ☐ Public ☐ Community

Comments:/Conditions: Keep Well 50' min. from Septic System
Install on Contour - Better Soil at 36" trench Bottom
Not to Scale

Comments:/Conditions:

INITIAL SITE SKETCH

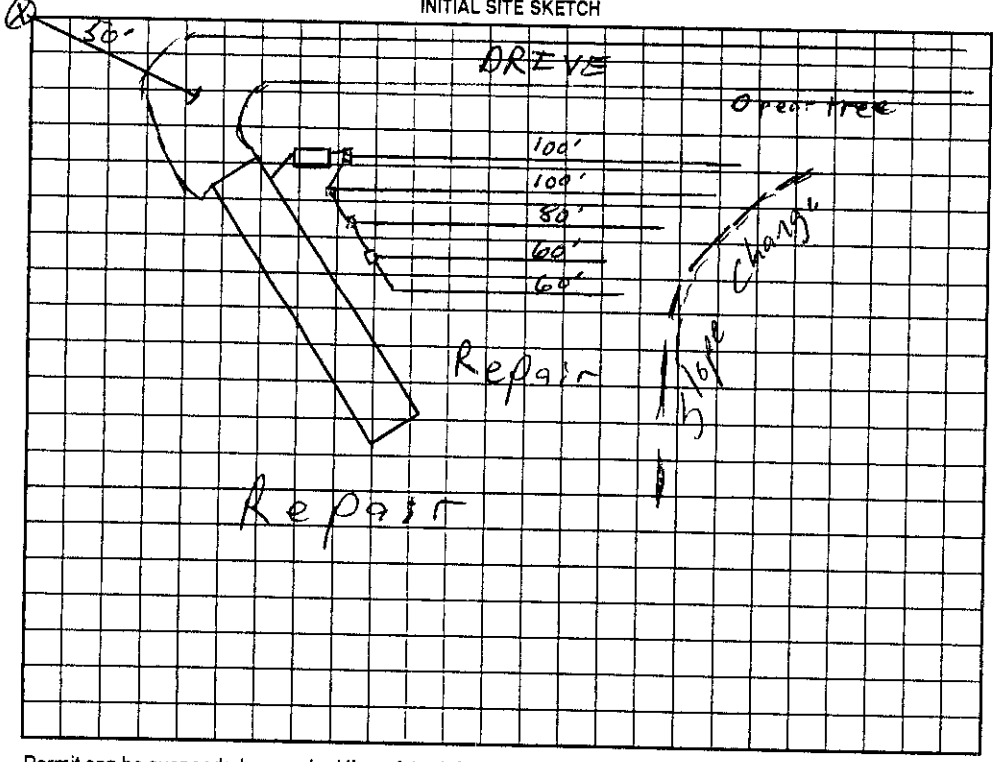

AS BUILT SKETCH

Installed As Drawn

Permit can be suspended or revoked if any false information is supplied toward securing the permit/any unauthorized changes are made to the site/any unauthorized changes are made in the installation of the system. Improvement Permit with plat valid without expiration. Improvement Permit with site plan valid for sixty months. Authorization to Construct is valid for a period equal to that of Improvement Permit – not to exceed sixty months.

Signed: Ryan N. Laney date 2/6/02 Installed by: Richard Abernathy

Improvement Permit by: RS date 2/5/02 Operation Permit by: RS date 2/21/02

Authorization to Construct by: RS date 2/5/02 Existing System Inspection by: date

HEALTH DEPT. COPY: WHITE OWNER COPY (FINAL): YELLOW OWNER COPY (INITIAL): PINK