...OUNTY HEALTH DEPARTMENT

STATESVILLE 704-878-5305 MOORESVILLE 704-664-5281

...EMENT PERMIT / AUTHORIZATION TO CONSTRUCT / OPERATION PERMIT / EXISTING SYSTEM INSPECTI...

T# 122882 PIN# 4636-49-2710 DATE Nov 29, 04

ER OR CONTRACTOR Niblock Dev. Corp PHONE: Business Home

ADDRESS 300 McGill Ave, Concord, N.C. 28027

LOCATION Brawley Sch Rd. TR Blume TR Heron's Gate Dr. on left

SUBDIVISION Edgewater Park BLOCK / SECTION LOT 35/35A LOT AREA .694Ac + .235Ac SITE CLASS PSSE DESIGN FLOW 440gpd L.T.A.R. e3 SSE 35A

Septic Tank: 1000 Gallons; STB 794 Date 11-27-06

Pump Tank: 1000 Gallons; PT 3 Date 12-3-04

Pump Make: no'Goulds Model WE 1512HH Serial No.

Nitrification Field: No Fields 1 Square Feet 540/810 Linear Feet 270

No Lines 6@45' Trench Width 24" min 36" Max Trench Bottom Depth 36" Gravel Depth NA

☐ New System ☐ Repair System Type: I, II, (III) IV, V, VI

System Description: pm - PPBPS

Repair System Description: pm PPBPS

Maintenance Agreement Required: ☐ Yes ☒ No

☒ House/Mod. Home No. Bedrooms 4

☐ Mobile Home No. Bathrooms

☐ Business No. Employees

☐ Other


☐ Slab ☒ Crawl Space ☐ Basement w/plumbing ☐ Basement wo/plumbing

Water Supply: ☒ Individual ☐ Public ☐ Community


Comments:/Conditions: or 36" min 9'oc Checked tanks 2/8/07

Comments:/Conditions: 60 panels Used Checked lines, pressure, elect & alarm 3/5/07

INITIAL SITE SKETCH 1"=50'

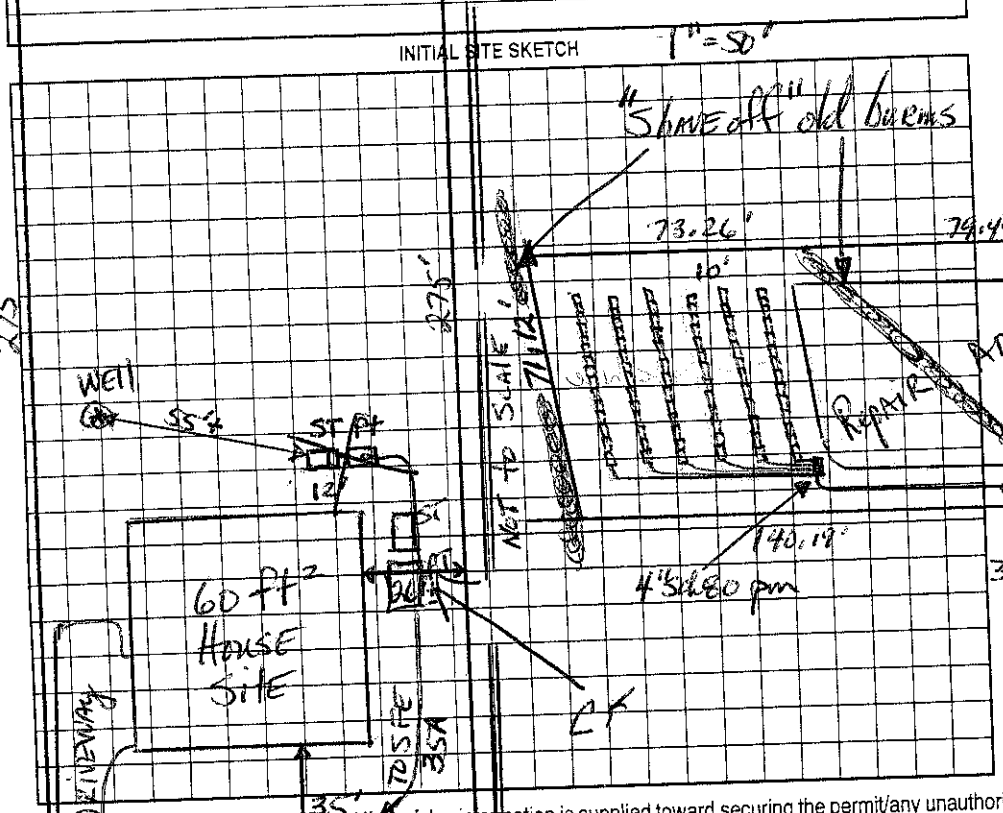

AS BUILT SKETCH

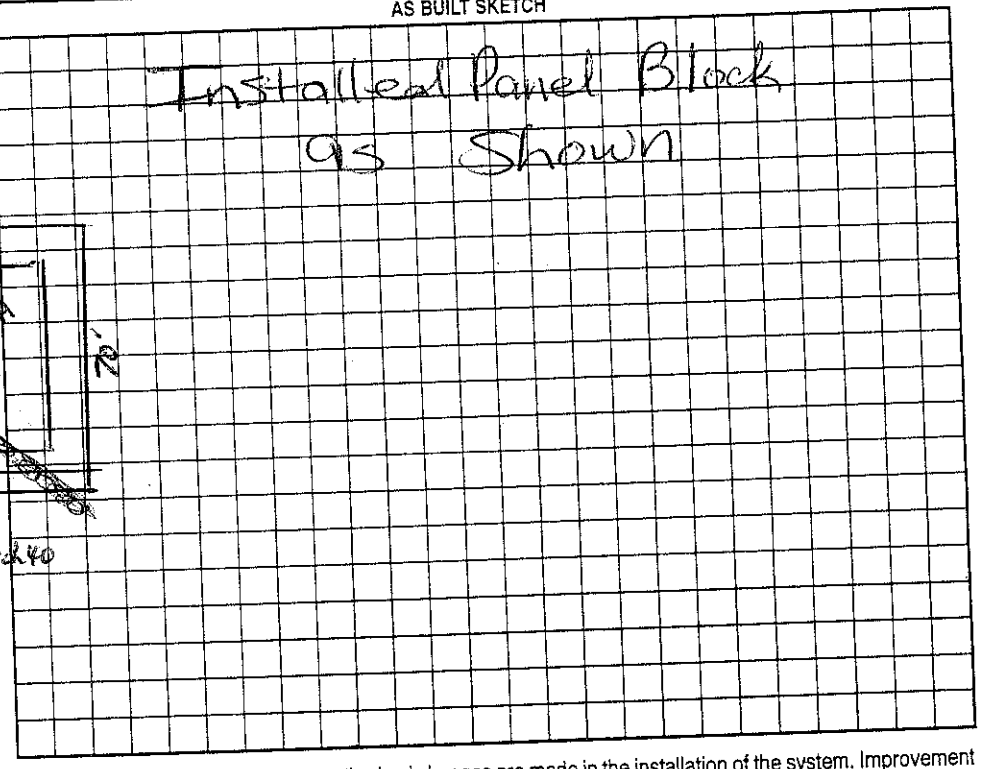

Permit can be suspended or revoked if any false information is supplied toward securing the permit/any unauthorized changes are made to the site/any unauthorized changes are made in the installation of the system. Improvement Permit with plat valid without expiration. Improvement Permit with site plan valid for sixty months. Authorization to Construct is valid for a period equal to that of Improvement Permit – not to exceed sixty months.

Signed: RW Heron's Gate Dr. Pat Lagunta date 3-1-05 Installed by: Larry Hinkle RS date 3/5/07

Improvement Permit by: D. Atkinson, RS date 11-29-04 Operation Permit by: Maisie M. Dobson RS date

Authorization to Construct by: Judy Melville date 9-13-06 Existing System Inspection by: date

HEALTH DEPT. COPY: WHITE OWNER COPY (FINAL): YELLOW OWNER COPY (INITIAL): PINK