IREDELL COUNTY HEALTH DEPARTMENT

STATESVILLE 704-878-5305 MOORESVILLE 704-664-5281

IMPROVEMENT PERMIT / AUTHORIZATION TO CONSTRUCT / OPERATION PERMIT / EXISTING SYSTEM INSPECTION

PERMIT# 122855 PIN# 4636-39-9719.061 9636-49-4498 DATE Jan 13, 05

OWNER OR CONTRACTOR Niblock Development PHONE: Business Home

ADDRESS 300 McGill Ave, NW, Concord, N.C. 28027

LOCATION Brawley School Rd TR Blume TR Heron's Gate Dr. on Right

SUBDIVISION Edgewater Park BLOCK / SECTION 3 LOT 61 LOT AREA .741 Ac SITE CLASS PS DESIGN FLOW 440 gpd L.T.A.R. .3

Septic Tank: 1000 Gallons; STB 312 Date 3-21-05
Pump Tank: Gallons; PT Date
Pump Make: Model Serial No.
Nitrification Field: No Fields 1 Square Feet 1200 Linear Feet 400
No Lines 5 Trench Width 36" Max Trench Bottom Depth 36" Gravel Depth NA

☒ New System ☐ Repair System Type: I, II, III, IV, V, VI
System Description: Conv w/ 25% Reduction
Repair System Description: pm/LPP 25-50% Reduction
Maintenance Agreement Required: ☐ Yes ☒ No


☒ House/Mod. Home No. Bedrooms 4
☐ Mobile Home No. Bathrooms
☐ Business No. Employees
☐ Other
☐ Slab ☒ Crawl Space ☐ Basement w/plumbing ☐ Basement wo/plumbing

Water Supply: ☒ Individual ☐ Public ☐ Community

Comments:/Conditions:
Do Not cut / lower house site OR a pump will be Required.
Exit plumbing at right rear where X'

Comments:/Conditions: Installing 4 lines
120' - 2 lowest lines
80' - 2 upper lines

INITIAL SITE SKETCH

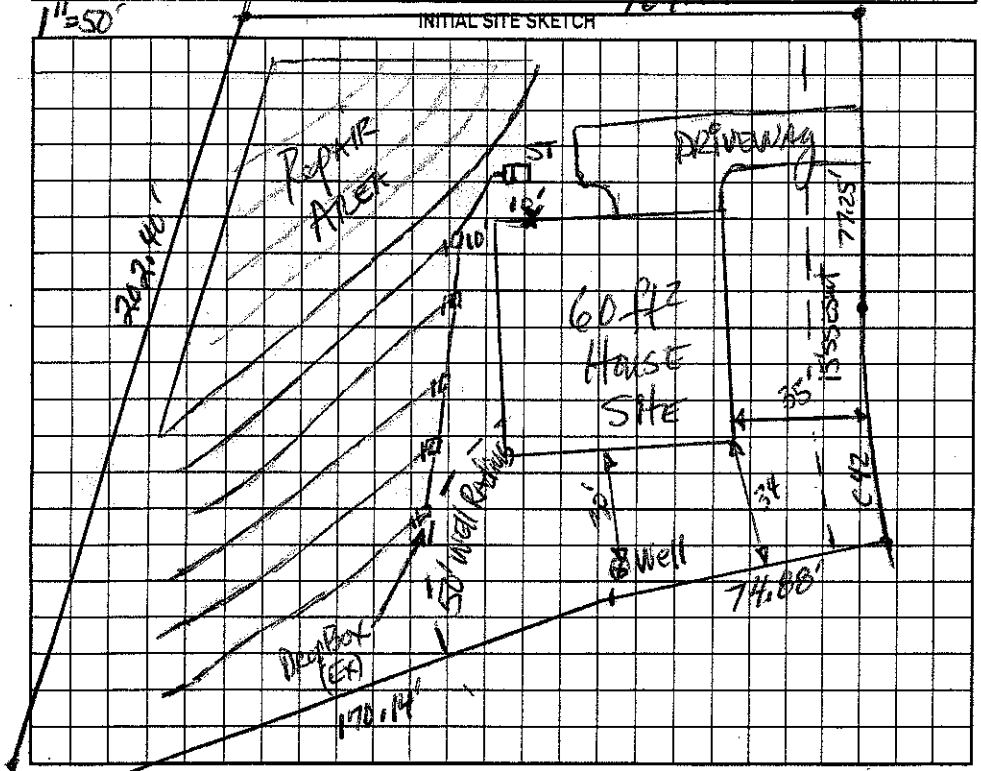

AS BUILT SKETCH

*Need to grade / taper over Drainlines close to house where lines are deep.

Permit can be suspended or revoked if any false information is supplied toward securing the permit/any unauthorized changes are made to the site/any unauthorized changes are made in the installation of the system. Improvement Permit with plat valid without expiration. Improvement Permit with site plan valid for sixty months. Authorization to Construct is valid for a period equal to that of Improvement Permit – not to exceed sixty months.

Signed: Pat Caporetto date 3-1-05 Installed by: Richard Abernathy

Improvement Permit by: [illegible] date Jan 13, 05 Operation Permit by: Maia H Dotson RS date 5/17/05

Authorization to Construct by: [illegible] RS date 4/5/05 Existing System Inspection by: date

HEALTH DEPT. COPY: WHITE OWNER COPY (FINAL): YELLOW OWNER COPY (INITIAL): PINK