IREDELL COUNTY HEALTH DEPARTMENT

STATESVILLE 704-878-5305 MOORESVILLE 704-664-5281

IMPROVEMENT PERMIT / AUTHORIZATION TO CONSTRUCT / OPERATION PERMIT / EXISTING SYSTEM INSPECTION

PERMIT# 122885 PIN# 4636-49-4755 DATE Jan 14, 05

OWNER OR CONTRACTOR Nicholds Development PHONE: Business Home

ADDRESS 300 McGill Ave, NW Concord, N.C. 28027

LOCATION Brawley School Rd TR Blume TR Heron's Gate Dr. Lot 37 on left, SFE 37A on Right

SUBDIVISION Edgewater Park BLOCK / SECTION LOT 37/37A LOT AREA .674ac & .394ac SITE CLASS PS SFE DESIGN FLOW 460gpd L.T.A.R. e3

Septic Tank: 1000 Gallons; STB 284 Date 7/23/05
Pump Tank: 1000 Gallons; PT 283 Date 7/23/05
Pump Make: Little Giant Model 9E1+ Serial No.
Nitrification Field: No Fields 1 Square Feet 1200 Linear Feet 400
No Lines 5 Trench Width 36" Max Trench Bottom Depth 36" Gravel Depth NA

☑ New System ☐ Repair System Type: I, II, III, IV, V, VI
System Description: PM 25% Reduction on SFE 37A
Repair System Description: LPP BPS on SFE 37A
Maintenance Agreement Required: ☐ Yes ☑ No initially

☑ House/Mod. Home No. Bedrooms 4
☐ Mobile Home No. Bathrooms
☐ Business No. Employees
☐ Other


☐ Slab ☑ Crawl Space ☐ Basement w/plumbing ☐ Basement wo/plumbing

Water Supply: ☑ Individual ☐ Public ☐ Community


Comments:/Conditions: Reviewed Building plans & Site plans; essentially in Compliance with original permit. Drive on opposite side of lot.

Comments:/Conditions:

INITIAL SITE SKETCH

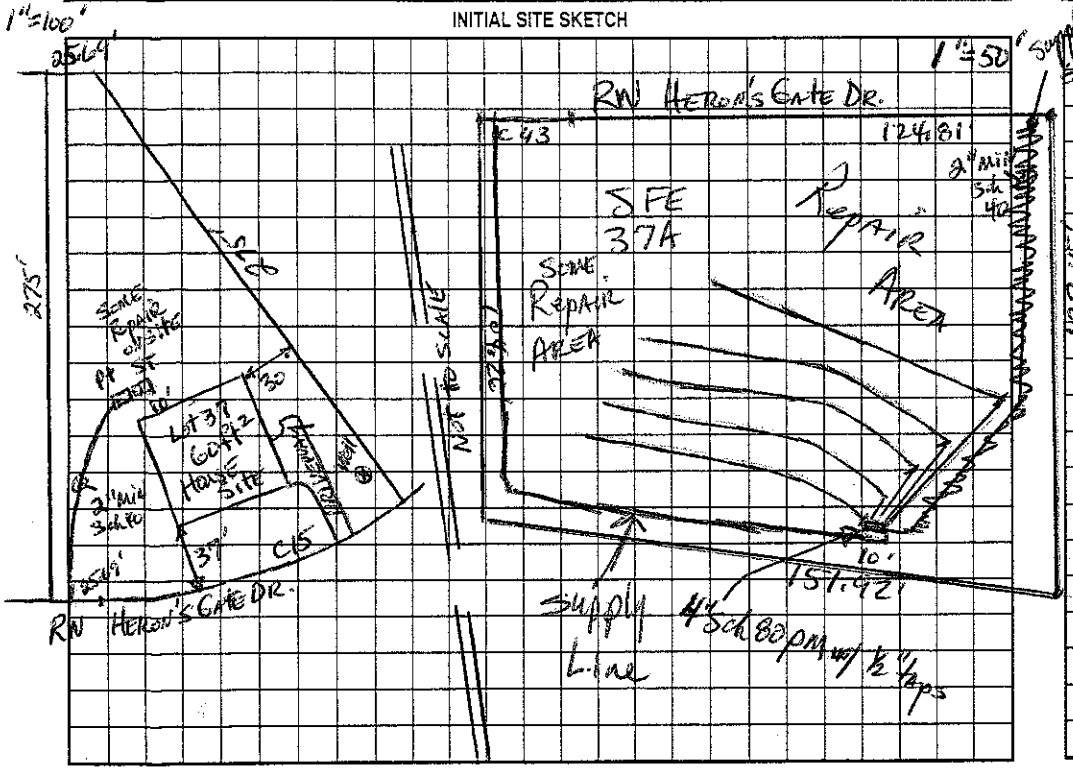

AS BUILT SKETCH

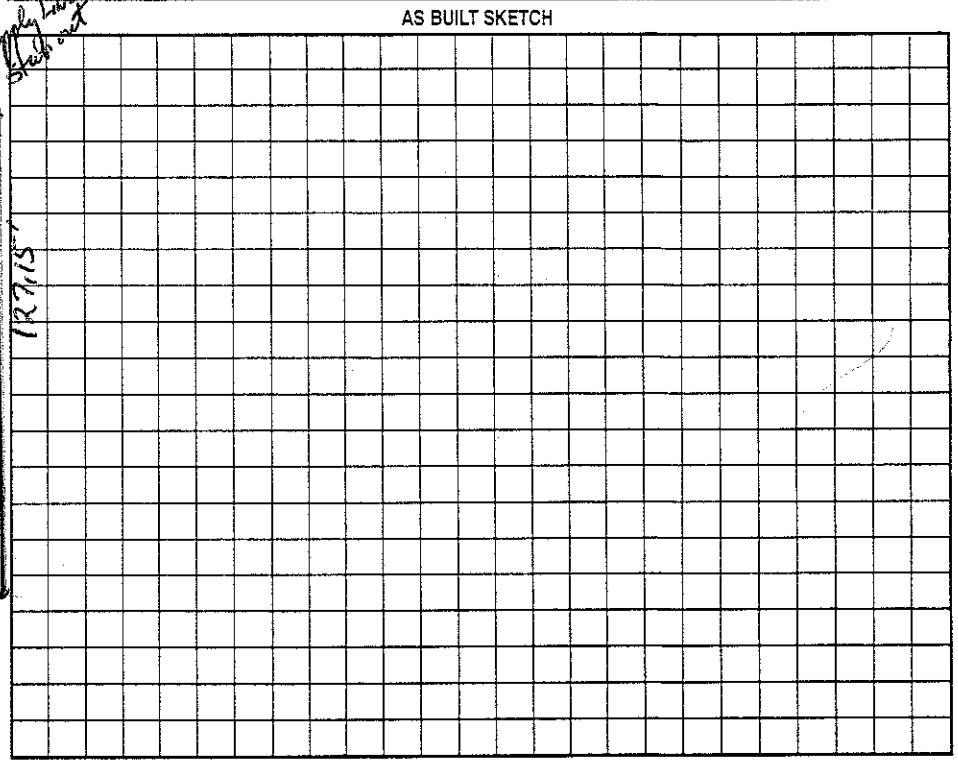

Permit can be suspended or revoked if any false information is supplied toward securing the permit/any unauthorized changes are made to the site/any unauthorized changes are made in the installation of the system. Improvement Permit with plat valid without expiration. Improvement Permit with site plan valid for sixty months. Authorization to Construct is valid for a period equal to that of Improvement Permit – not to exceed sixty months.

Signed: Pat Carpenter date 3-1-05 Installed by: Abernathy

Improvement Permit by: date 1-14-05 Operation Permit by: RS date 9/9/05

Authorization to Construct by: date RS 5/3/05 Existing System Inspection by: date

HEALTH DEPT. COPY: WHITE OWNER COPY (FINAL): YELLOW OWNER COPY (INITIAL): PINK