IREDELL COUNTY HEALTH DEPARTMENT

STATESVILLE 704-878-5305 MOORESVILLE 704-664-5281

IMPROVEMENT PERMIT / AUTHORIZATION TO CONSTRUCT / OPERATION PERMIT / EXISTING SYSTEM INSPECTION

PERMIT# 122886 PIN# 4636-49-5803 DATE Nov 30, 04

OWNER OR CONTRACTOR Niblock Dev Corp PHONE: Business Home

ADDRESS 300 McGill Ave Concord N.C. 28027

LOCATION Brantley Sch Rd TR Blume TR Herons Gate Dr. on left

SUBDIVISION Edgewater Park BLOCK / SECTION LOT 38 LOT AREA .7 Ac SITE CLASS PS DESIGN FLOW 480gpd L.T.A.R. .3

Septic Tank: 1000 Gallons; STB 312 Date 12/16/03

Pump Tank: 1000 Gallons; PT 287 Date 7/26/05

Pump Make: Little Giant Model 9EH Serial No.

Nitrification Field: No Fields 1 Square Feet 540/810 Linear Feet 270

No Lines 4 Trench Width 24" Min 8'oc Max Trench Bottom Depth 36" Gravel Depth NA

☑ New System ☐ Repair System Type: I, II, III, IV, V, VI

System Description: LPPPBPS

Repair System Description: LPPPBPS

Maintenance Agreement Required: ☑ Yes ☐ No

☑ House/Mod. Home No. Bedrooms 4

☐ Mobile Home No. Bathrooms

☐ Business No. Employees

☐ Other

☐ Slab ☑ Crawl Space ☐ Basement w/plumbing ☐ Basement wo/plumbing


Water Supply: ☑ Individual ☐ Public ☐ Community

Comments:/Conditions: see 36" max 9'oc

Reviewed Build plan & site plan, essentially in Compliance with Improvement Permit

Comments:/Conditions:

INITIAL SITE SKETCH 1"=50'

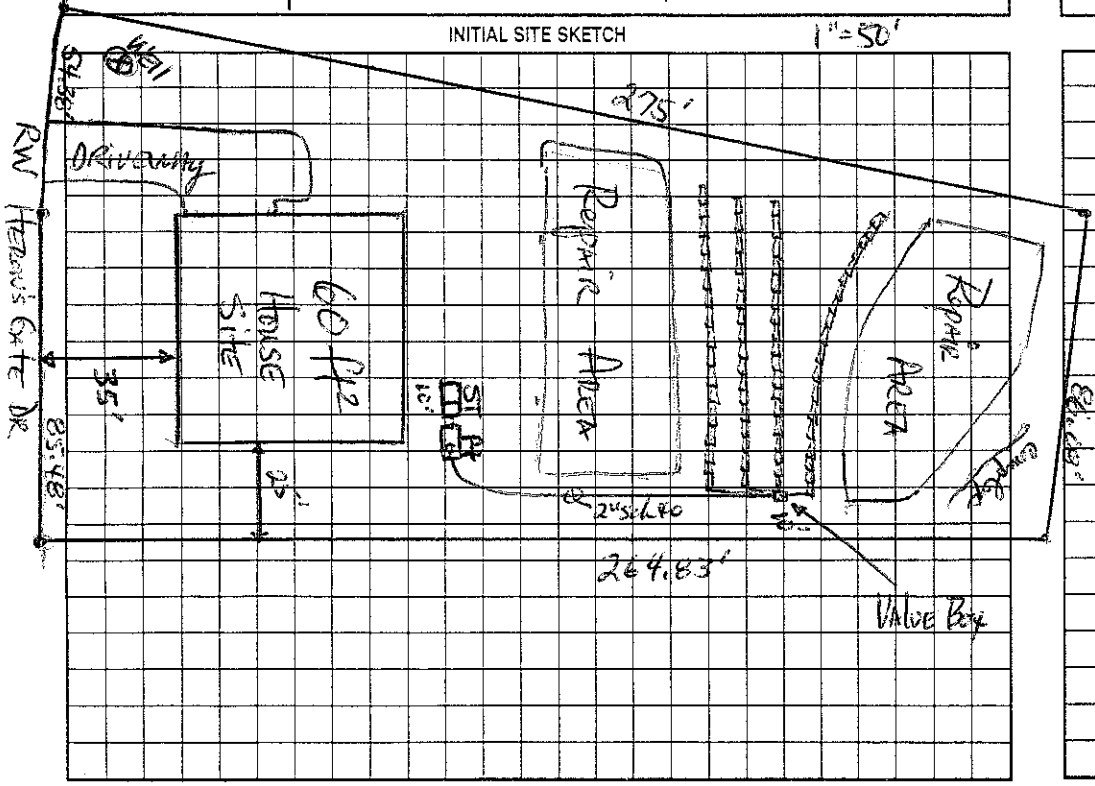

AS BUILT SKETCH

Permit can be suspended or revoked if any false information is supplied toward securing the permit/any unauthorized changes are made to the site/any unauthorized changes are made in the installation of the system. Improvement Permit with plat valid without expiration. Improvement Permit with site plan valid for sixty months. Authorization to Construct is valid for a period equal to that of Improvement Permit – not to exceed sixty months.

Signed: Pat Carpenter date 3-1-05 Installed by: Abernathy

Improvement Permit by: DHathman RS date 11-30-04 Operation Permit by: RS date 9/12/05

Authorization to Construct by: RS date 5/3/05 Existing System Inspection by: date

HEALTH DEPT. COPY: WHITE OWNER COPY (FINAL): YELLOW OWNER COPY (INITIAL): PINK