IREDELL COUNTY HEALTH DEPARTMENT

STATESVILLE 704-878-5305 MOORESVILLE 704-664-5281

IMPROVEMENT PERMIT / AUTHORIZATION TO CONSTRUCT / OPERATION PERMIT / EXISTING SYSTEM INSPECTIO

PERMIT# 122854 PIN# ~~4636-39-9719.000~~ 9636496511.000 DATE Jan 13, 05

OWNER OR CONTRACTOR Nipforte Development PHONE: Business Home

ADDRESS 300 McGill Ave, NW Concord, N.C. 28027

LOCATION Brawley School RD TR Plume TR Heron's Gate DR on Right

SUBDIVISION Edgewater Park BLOCK / SECTION III LOT 60 LOT AREA .70Ac SITE CLASS RS DESIGN FLOW 480gpd L.T.A.R. .3

Septic Tank: 1000 Gallons; STB 7044 Date 1-1-06
Pump Tank: 1000 Gallons; PT 2883 Date 6-18-06
Pump Make Gaulds Model PE5TM Serial No.
Nitrification Field: No Fields 1 Square Feet 1200 Linear Feet 400
No Lines 4@100' Trench Width 36" Max Trench Bottom Depth 36" Gravel Depth N/A

☑ New System ☐ Repair System Type: I, II, (III), IV, V, VI
System Description: PM 25% Reduction
Repair System Description: SAME
Maintenance Agreement Required: ☐ Yes ☑ No

☑ House/Mod. Home No. Bedrooms 4
☐ Mobile Home No. Bathrooms
☐ Business No. Employees
☐ Other
☐ Slab ☑ Crawl Space ☐ Basement w/plumbing ☐ Basement wo/plumbing


Water Supply: ☑ Individual ☐ Public ☐ Community

Comments:/Conditions: 4/13/06 Reviewed site plans & Building plans; essentially in Compliance with original permit


Comments:/Conditions: Note: Drive on other side of lot. Checked tanks 8/4/06 Installed Disap. block

1"=50'

INITIAL SITE SKETCH

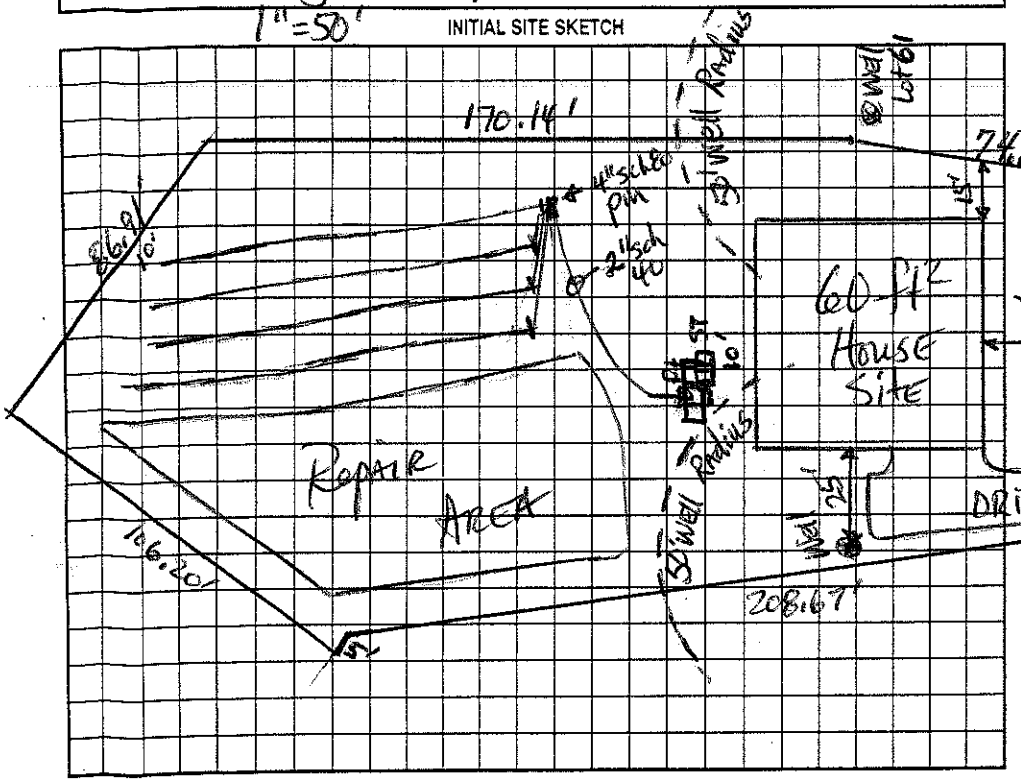

AS BUILT SKETCH

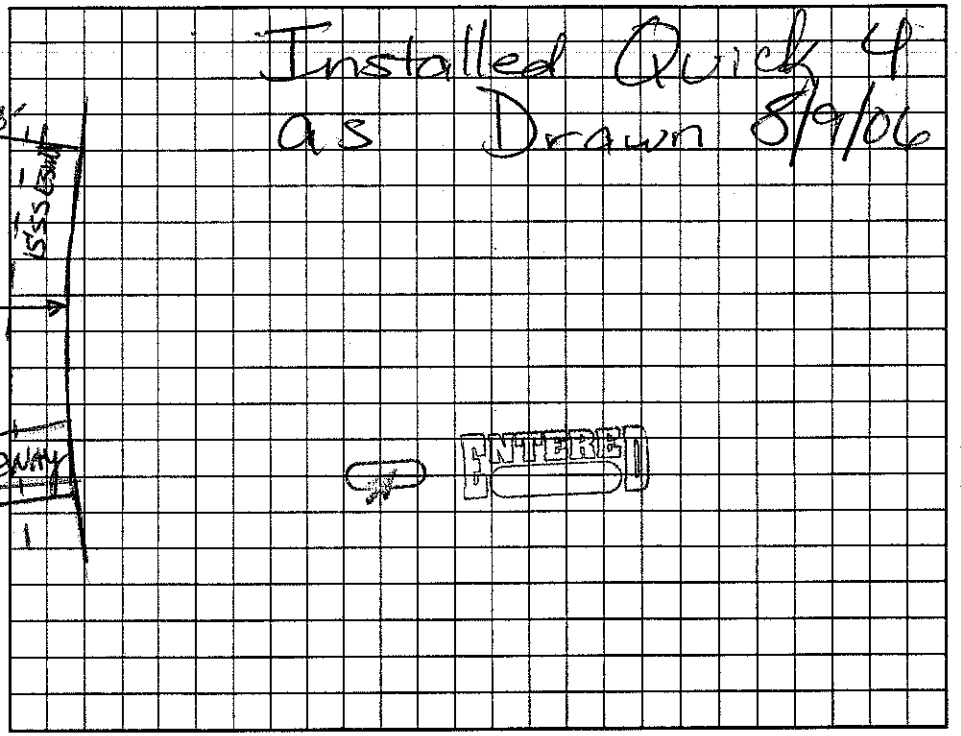

Permit can be suspended or revoked if any false information is supplied toward securing the permit/any unauthorized changes are made to the site/any unauthorized changes are made in the installation of the system. Improvement Permit with plat valid without expiration. Improvement Permit with site plan valid for sixty months. Authorization to Construct is valid for a period equal to that of Improvement Permit – not to exceed sixty months.

Signed: Pat Carpenter date 3-1-05 Installed by: Larry Hinkle RS.

Improvement Permit by: DM date 1-13-05 Operation Permit by: Maria H Dolson date 8/11/06

Authorization to Construct by: Maria H Dolson RS date 4/13/06 Existing System Inspection by: date

HEALTH DEPT. COPY: WHITE OWNER COPY (FINAL): YELLOW OWNER COPY (INITIAL): PINK