IREDELL COUNTY HEALTH DEPARTMENT

STATESVILLE 704-878-5305 MOORESVILLE 704-664-5281

IMPROVEMENT PERMIT / AUTHORIZATION TO CONSTRUCT / OPERATION PERMIT / EXISTING SYSTEM INSPECTION

PERMIT # Repair PIN # 4636049970 3 DATE 5-26-09

OWNER or APPLICANT Robert R. Cush Sr. PHONE: Business Home:

OWNER or APPLICANT ADDRESS 138 Egrets Walk Place Mooresville, NC 28117

LOCATION / DIRECTIONS Brawley School Rd TR Blume TR Heron's Gate TR Egrets Walk on right

SUBDIVISION Edgewater Park BLOCK / SECTION LOT # 56 LOT AREA .691AC DESIGN FLOW 480gpd L.T.A.R. .3

EXIST Septic Tank 1000 Gallons: STB Date

EXIST Pump Tank 1000 Gallons: P T Date

Pump Make Model Serial #

EXIST Nitrification Field No Fields 1 No Lines 5 Linear Feet 400

EXIST Trench Width 36" Max. Trench Bottom Depth 36" Gravel Depth N/A ☐ GRAVITY ☒ PRESSURE

☐ New System ☒ Repair ☐ Expansion System Type I II III (IV) V VI

System Description: Pump-LP-25% Reduction

Repair System Description: Pump-LP 50% Reduction

Maintenance Agreement Required ☒ YES ☐ NO

☒ Residence No. Bedrooms 4 ☐ Business No. Persons ☐ Other No. Employees ☐ Slab ☐ Crawl Space ☐ Basement w/plumbing ☐ Basement w/o plumbing


Water Supply ☒ Private ☐ Public ☐ Community

Comments / Conditions See Attached permit for Full View OF Site layout.


Comments / Conditions ☆ Install "Check Valves" on Upper 2 drainlines to prevent bleed back into Valve box.

PL 8273

INITIAL SITE SKETCH

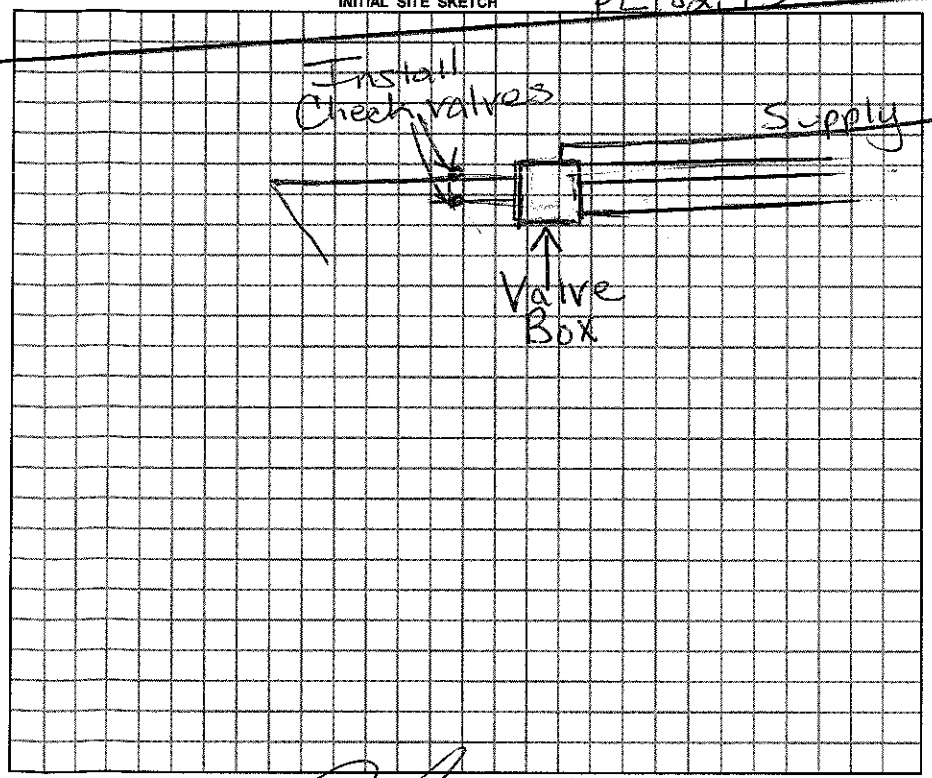

AS BUILT SKETCH

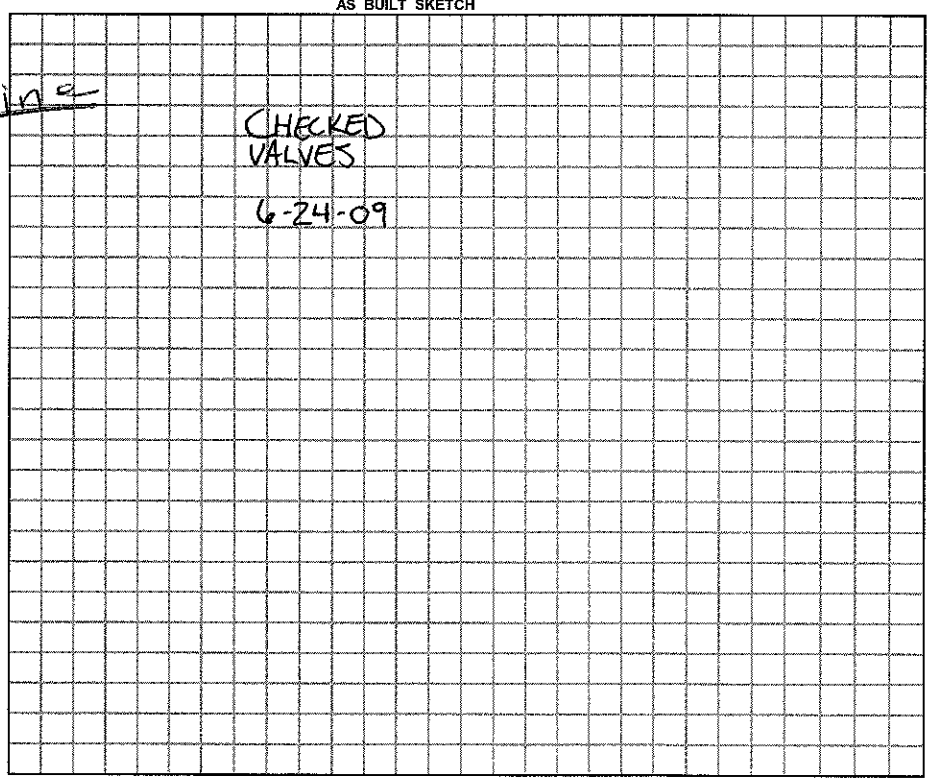

PL

Permit can be suspended or revoked if any false information is supplied toward securing the permit / any unauthorized changes are made to the site / any unauthorized changes are made in the installation of the system.

☐ *IMPROVEMENT PERMIT w / plat valid without expiration.* ☐ *IMPROVEMENT PERMIT w / site plan valid for 60 mos.* ☐ *AUTHORIZATION TO CONSTRUCT valid for period equal to IMPROVEMENT PERMIT-not to exceed 60 mo.*

Owner / Applicant Signature: Date 5/26/09

Improvement Permit by: Date 5/26/09

Authorzation to Construct by: RS Date 5/26/09

YOU SHOULD CONTACT A LOCATOR SERVICE PRIOR TO ANY EXCAVATION.

Installed by: LARRY HINKLE

Operation Permit by: Date: 6-24-09

Existing System Inspected by Date:

WHITE COPY Environmental Health YELLOW COPY (Final) Owner / Applicant PINK COPY (Initial) Owner / Applicant