IREDELL COUNTY HEALTH DEPARTMENT

STATESVILLE 704-878-5305 MOORESVILLE 704-664-5281

IMPROVEMENT PERMIT / AUTHORIZATION TO CONSTRUCT / OPERATION PERMIT / EXISTING SYSTEM INSPECTION

PERMIT# 122827 PIN# ~~4636-39-9713.000~~ 4636449703.000 DATE Jan 13, 05

OWNER OR CONTRACTOR Pitbull Development PHONE: Business _____ Home _____

ADDRESS 300 McGill Ave, NW Concord, N.C. 28027

LOCATION Brawley Sch Rd. TR Blume TR Heaton's Gate TR Eggets Walk on Right

SUBDIVISION Edgewater Park BLOCK / SECTION _____ LOT 56 LOT AREA .691 Ac SITE CLASS PS DESIGN FLOW 450 gpd L.T.A.R. .03

Septic Tank: 1000 Gallons; STB 794 Date 4-30-04
Pump Tank: 1000 Gallons; P.T 2813 Date 8-15-04
Pump Make: Goulds Model WE0712H Serial No. _____
Nitrification Field: No Fields 1 Square Feet 1200 Linear Feet 400
No Lines 5 Trench Width 36" Max Trench Bottom Depth 36" Gravel Depth N/A

☑ New System ☐ Repair System Type: I, II, III, ⓘ, V, VI
System Description: LP 25% Reduction
Repair System Description: LP 25-50% Reduction
Maintenance Agreement Required: ☑ Yes ☐ No


☑ House/Mod. Home No. Bedrooms 4
☐ Mobile Home No. Bathrooms ____
☐ Business No. Employees ____
☐ Other ____

☐ Slab ☑ Crawl Space ☐ Basement w/plumbing ☐ Basement wo/plumbing

Water Supply: ☑ Individual ☐ Public ☐ Community

Comments/Conditions:
Use 1¼" Sch 40 min Through 25% Reduction Laterals with one 3/16" hole every 5', No holes within 5' beginning or end of Laterals. 2' min pressure head. Turn ups at lateral ends must have protective covers (Valve covers)

INITIAL SITE SKETCH

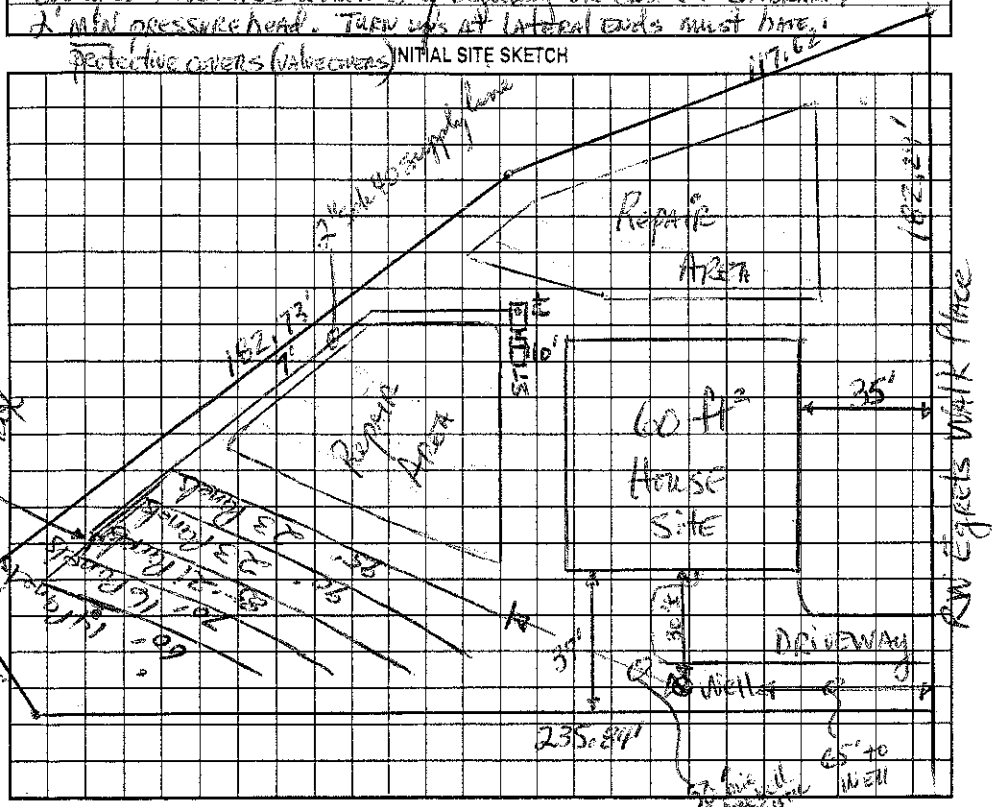

Comments/Conditions:
Pitbull 4 Panels, 16 Panels, 21 Panels
23 Panels in 1st, 2 ditches
3/16" hole drilled every 5ft
Tanks & lines checked 12/6/06

AS BUILT SKETCH

Pres, Elect & Alarm 12/5/06 MRD

Permit can be suspended or revoked if any false information is supplied toward securing the permit/any unauthorized changes are made to the site/any unauthorized changes are made in the installation of the system. Improvement Permit with plat valid without expiration. Improvement Permit with site plan valid for sixty months. Authorization to Construct is valid for a period equal to that of Improvement Permit – not to exceed sixty months.

Signed: Pat Carpenter date 3-1-05
Improvement Permit by: D.K. Thomson, RS date 1-13-05
Authorization to Construct by: _____ RS date 7/21/04

Installed by: Larry Tinkle
Operation Permit by: Mark H. Dotson, RS date 12/8/06
Existing System Inspection by: _____ date _____

HEALTH DEPT. COPY: WHITE OWNER COPY (FINAL): YELLOW OWNER COPY (INITIAL): PINK