Y-00 (Y-00)

IREDELL COUNTY HEALTH DEPARTMENT

STATESVILLE 704-878-5305 MOORESVILLE 704-664-5281

IMPROVEMENT PERMIT / CERTIFICATE OF COMPLETION / OPERATION PERMIT / EXISTING SYSTEM INSPECTION

PROPERTY DESCRIPTION NO. 20879 DATE 7/9/97 TAX MAP NO. 2G 8A 6 Watershed: X Yes ☐ No

OWNER OR CONTRACTOR Doug Brindstaff PHONE: Business Home 664-4418

ADDRESS 160 Southwood Park Rd Mooresville NC. 28115 4636-50-0465

LOCATION 1100, Tl Stutts Rd. TR Baywatch Dr., Last lot on (R)

SUBDIVISION Marina Village BLOCK / SECTION LOT 6 LOT AREA ~3/4 AC. SITE CLASS. PS DESIGN FLOW 360 L.T.A.R. .3

Septic Tank: 1000 Gallons; STB 794 Date 2/3/99

Pump Tank: Gallons; PT Date

Pump Make: Model Serial No.

Nitrification Field: No. Fields 1 Square Feet 900* Linear Feet 300*

No Lines X (5) Trench Width 36" Max Trench Bottom Depth 36" Gravel Depth SAND

X New System ☐ Repair System Type: I, II, (III) IV, V, VI

System Description: GRAV - CH PLASTIC *

Repair System Description: GRAV - PVBS 16"

Maintenance Agreement Required: ☐ Yes X No

X House/Mod. Home No. Bedrooms 3

☐ Mobile Home No. Bathrooms 2

☐ Business No. Employees

☐ Other

☐ Slab X Crawl Space ☐ Basement w/plumbing ☐ Basement wo/plumbing


Water Supply: X Individual ☐ Community ☐ Public

Comments: * 25% reduction for CH PLASTIC DRAINFIELD

UPPER 2 LINES CHECKED

Comments: 5 lines installed

INITIAL SITE SKETCH 1" = 50'

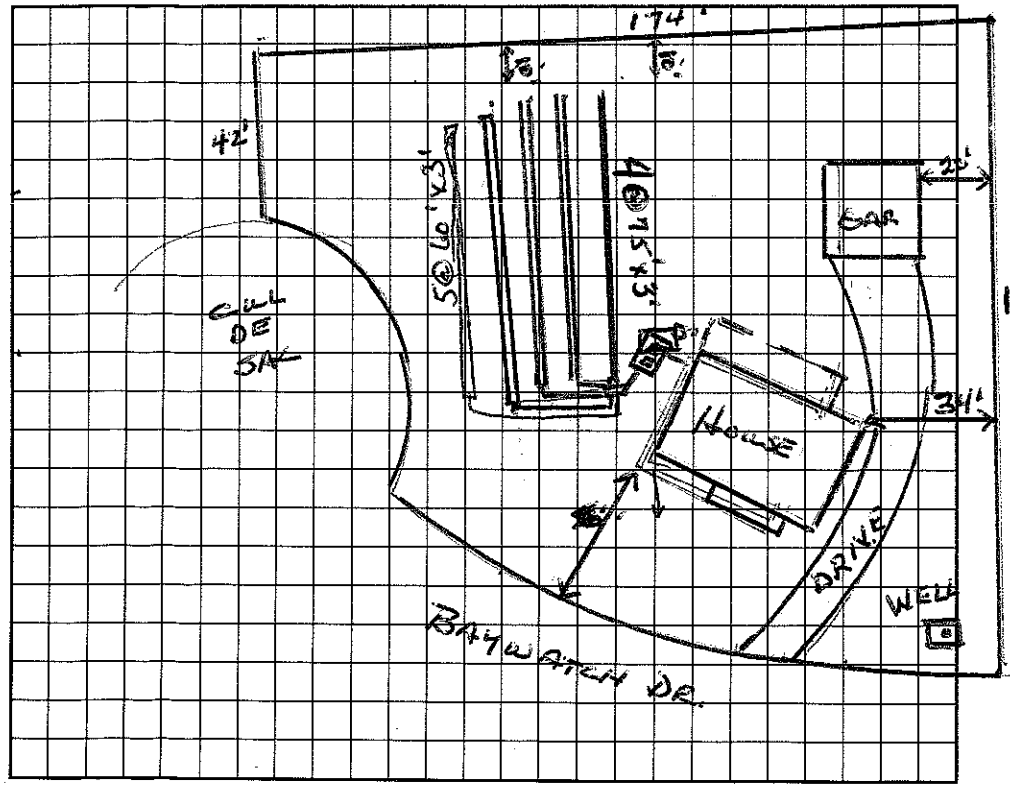

AS BUILT SKETCH

I understand that this permit can be suspended or revoked if any false information is supplied toward securing the permit/any unauthorized changes are made to the site/any unauthorized changes are made in the installation of the system. Improvement Permit is valid for 60 months from date of issuance.

Signed: * Doug Brindstaff

Improvement Permit by: Wesley Sparks RS. date 7/9/97

Existing System Inspection by: Wesley Sparks RS. date 7/9/97

Installed by: Curt Dunning

Certificate of Completion by: Wesley Sparks RS. date 4/20/99

Operation Permit by: Wesley Sparks RS. date 4/20/99

HEALTH DEPT. COPY: WHITE INSPECTION COPY (FINAL): GREEN OWNER COPY (FINAL): YELLOW INSPECTION COPY (INITIAL): PINK OWNER COPY (INITIAL): GOLD