IREDELL COUNTY HEALTH DEPARTMENT

STATESVILLE 704-878-5305 MOORESVILLE 704-664-5281

IMPROVEMENT PERMIT / AUTHORIZATION TO CONSTRUCT / OPERATION PERMIT / EXISTING SYSTEM INSPECTION

PERMIT# 141192 PIN# 4636501650.000

OWNER OR APPLICANT Vicki Bovaird DATE 8/6/07

ADDRESS 156 Main View Dr. Mooresville NC 28117 PHONE: Business 704-892-2563 Home 704-664-7672

LOCATION Brawley school Rd. TL on Stutts Rd. TR on Marina Ln. on Left

SUBDIVISION Commodore Peninsula BLOCK / SECTION ____ LOT 251 LOT AREA ±.28ac SITE CLASS. PS DESIGN FLOW 360 L.T.A.R. ±3

Septic Tank: 1000 Gallons: STB 825 Date 11/1/07

Pump Tank: ____ Gallons: PT ____ Date ____

Pump Make: ____ Model ____ Serial No. ____

Nitrification Field: No Fields 1 Square Feet 400 Linear Feet 200

No Lines 5@40' Trench Width 24" Max Trench Bottom Depth 36"

☑ New System ☐ Repair ☐ Expansion System Type: I II (III) IV V VI

System Description: Gravity PPBPS

Repair System Description: Exempt pre-1977

Maintenance Agreement Required: ☐ Yes ☑ No

Gravel Depth N/A ☑ Gravity ☐ Pressure

☑ House/Mod. Home ☐ Mobile Home ☐ Business ☐ Other

No. Bedrooms 3 No. Persons ____ No. Employees ____

Water Supply: ☐ Individual ☑ Public ☐ Community


☐ Slab ☑ Crawl Space ☐ Basement w/plumbing ☐ Basement wo/plumbing

Comments:/Conditions: If using equal distribution with drop box use flow levelers. * Keep drainline min 10' from top of embankment

Comments:/Conditions:

1" = 40'

INITIAL SITE SKETCH

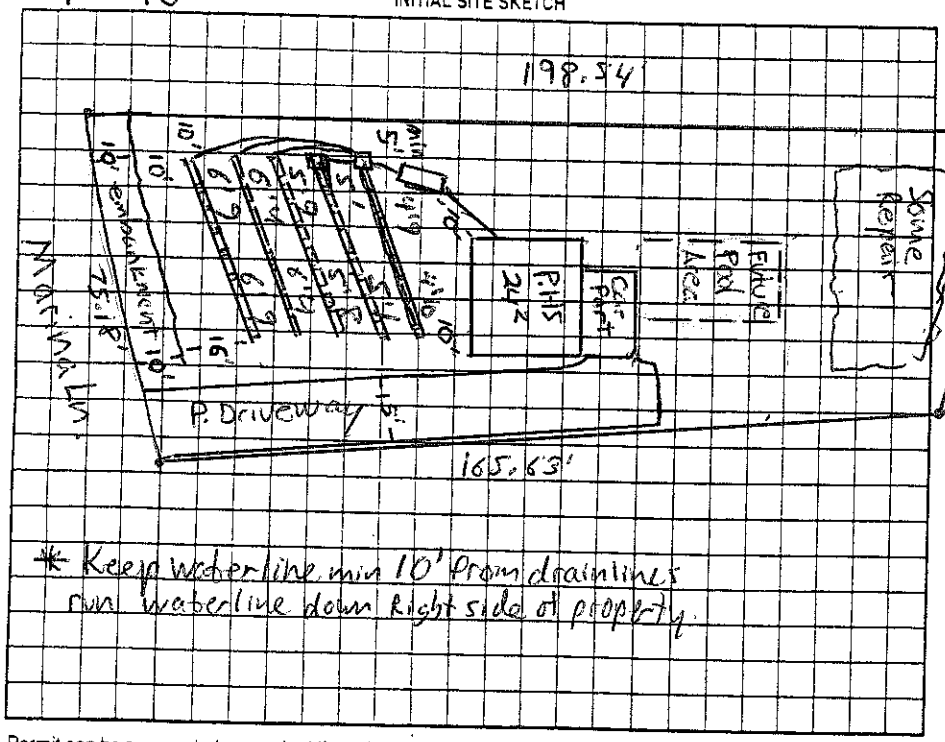

* Keep waterline min 10' from drainlines run waterline down Right side of property.

AS BUILT SKETCH

System installed as designed

12/10/07 JC

Permit can be suspended or revoked if any false information is supplied toward securing the permit/any unauthorized changes are made to the site/any unauthorized changes are made in the installation of the system. Improvement Permit with plat valid without expiration ☐ Improvement Permit with site plan valid for sixty months ☑ Authorization to Construct is valid for a period equal to that of Improvement Permit – not to exceed sixty months.

Signed: [signature] date 8/7/07

Improvement Permit by: Anthony Cokes Jr. date 8/6/07

Authorization to Construct by: Anthony Cokes Jr. date 8/6/07

Installed by: Rowan Septic

Operation Permit by: Anthony Cokes Jr. date 12/10/07

Existing System Inspection by: ____ date ____

HEALTH DEPT. COPY: WHITE OWNER COPY (FINAL): YELLOW OWNER COPY (INITIAL): PINK