4636501876

IREDELL COUNTY HEALTH DEPARTMENT

STATESVILLE 704-878-5305 MOORESVILLE 704-664-5281

IMPROVEMENT PERMIT / CERTIFICATE OF COMPLETION / OPERATION PERMIT / EXISTING SYSTEM INSPECTION

PROPERTY DESCRIPTION NO. REPAIR DATE 2/10/95 TAX MAP NO. 2G 07 260 Watershed: ☐ Yes ☐ No

OWNER OR CONTRACTOR ROBERT G SMITH PHONE: Business _____ Home 664-1948

ADDRESS 130 MARINA LN. MOORESVILLE, NC.

LOCATION STUTTS RD OFF BRAWLEY SCH TRN MARINA ON (R) # 130

SUBDIVISION SURFWOOD PARK BLOCK / SECTION A LOT 260 LOT AREA EXISTING SITE CLASS. ? DESIGN FLOW 240 L.T.A.R. _____

Septic Tank: 900 Gallons; STB _____ Date _____

Pump Tank: _____ Gallons; PT _____ Date _____

Pump Make: _____ Model _____ Serial No. _____

Nitrification Field: No Fields 1 Square Feet 200 Linear Feet ~~200~~ 120

No Lines ~~4~~ 2 Trench Width 24" Max Trench Bottom Depth 36" Gravel Depth 6" SAND

☐ New System ☑ Repair System Type: I, II, (III) IV, V, VI

System Description: GRAVITY - PDBS

Repair System Description: _____

Maintenance Agreement Required: ☐ Yes ☐ No

☑ House/Mod. Home No. Bedrooms 2

☐ Mobile Home No. Bathrooms 1

☐ Business No. Employees _____

☐ Other _____

☐ Slab ☐ Crawl Space ☑ Basement w/plumbing ☐ Basement wo/plumbing


Water Supply: ☐ Individual ☐ Community ☐ Public

Comments: ADDING SEPERATE TANK AND LINE FOR WASHING MACHINE. - Bull Run Valve - Dist Box w/Speed Leveler

LAKE

Comments: Installed two lines as

INITIAL SITE SKETCH

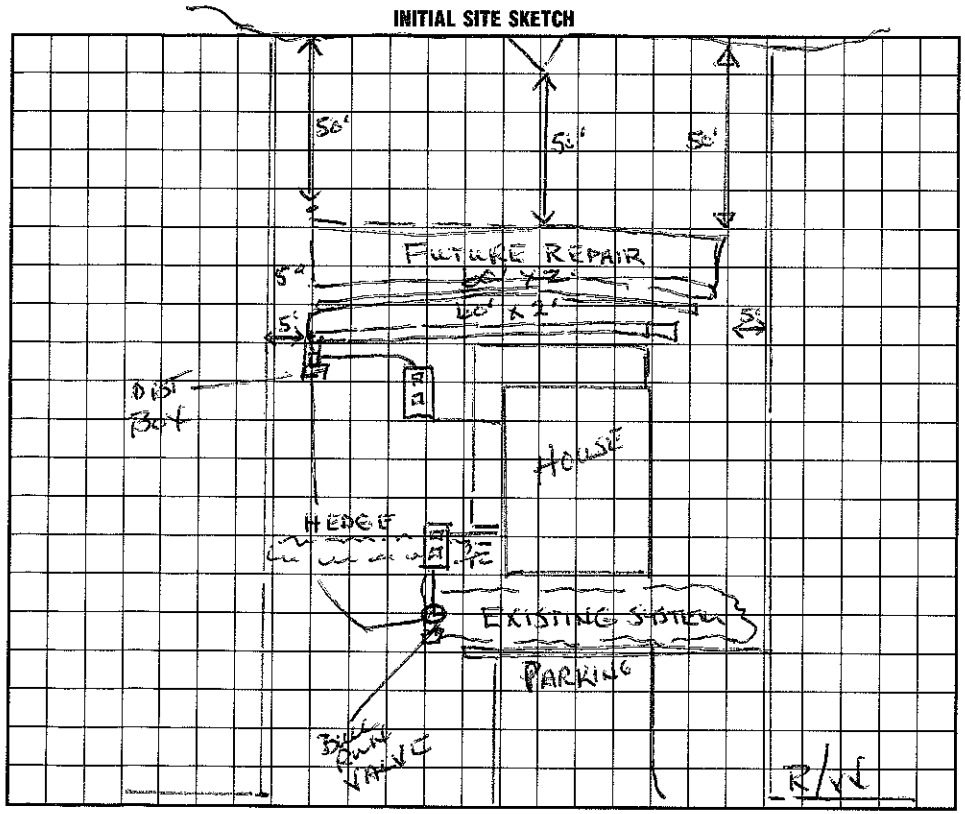

AS BUILT SKETCH

I understand that this permit can be suspended or revoked if any false information is supplied toward securing the permit/any unauthorized changes are made to the site/any unauthorized changes are made in the installation of the system. Improvement Permit is valid for 60 months from date of issuance.

Signed: _____

Improvement Permit by: Wesley Sparks R.S. date 2/10/95

Existing System Inspection by: _____ date _____

Installed by: Tim Simmons

Certificate of Completion by: Wesley Sparks R.S. date 4/10/95

Operation Permit by: _____ date _____

HEALTH DEPT. COPY: WHITE INSPECTION COPY (FINAL): GREEN OWNER COPY (FINAL): YELLOW INSPECTION COPY (INITIAL): PINK OWNER COPY (INITIAL): GOLD