IREDELL COUNTY HEALTH DEPARTMENT

AUTHORIZATION TO CONSTRUCT

STATESVILLE 704-878-5305 MOORESVILLE 704-664-5281

IMPROVEMENT PERMIT / ~~CERTIFICATE OF COMPLETION~~ / OPERATION PERMIT / EXISTING SYSTEM INSPECTION

PROPERTY DESCRIPTION NO. 25241 DATE 10/30/96 TAX MAP NO. 26-5-A-30 Watershed: ☑ Yes ☐ No

OWNER OR CONTRACTOR JOHN COLLIER JR. ~~PHONE: Business~~ 4636-50-4011 Home 664-7777

ADDRESS ISLE OF PINES RD, MOORESVILLE NC 28115

LOCATION BRAWLEY SCHOOL RD - TL STUTTS RD TR BAYWATCH TL SOUTHWOOD 3RD LOT ON LT

SUBDIVISION MARINA VILLAGE BLOCK / SECTION ____ LOT 50 LOT AREA 120 X 166 SITE CLASS. PS DESIGN FLOW 360 GPD L.T.A.R. .3 GPD/FT²

Septic Tank: 1000 Gallons; STB 1012 Date 7/24/98

Pump Tank: ____ Gallons; PT ____ Date ____

Pump Make: ____ Model ____ Serial No. ____

Nitrification Field: No Fields 1 Square Feet 600 Linear Feet 200

No Lines 4 @ 50' Trench Width 24" Max Trench Bottom Depth 36" Gravel Depth N/A

☑ New System ☐ Repair System Type: I, II, III, IV, V, VI

System Description: GRAVITY PANEL

Repair System Description: SAME

Maintenance Agreement Required: ☐ Yes ☑ No

☑ House/Mod. Home No. Bedrooms 3

☐ Mobile Home No. Bathrooms 2.5

☐ Business No. Employees ____

☐ Other ____


☐ Slab ☑ Crawl Space ☐ Basement w/plumbing ☐ Basement wo/plumbing

Water Supply: ☑ Individual ☐ Community ☐ Public

Comments:

Comments:
9/25/98 No well on lot.
INSTALLED AS DRAWN USING FLOW DIVIDERS

INITIAL SITE SKETCH 1"=40'

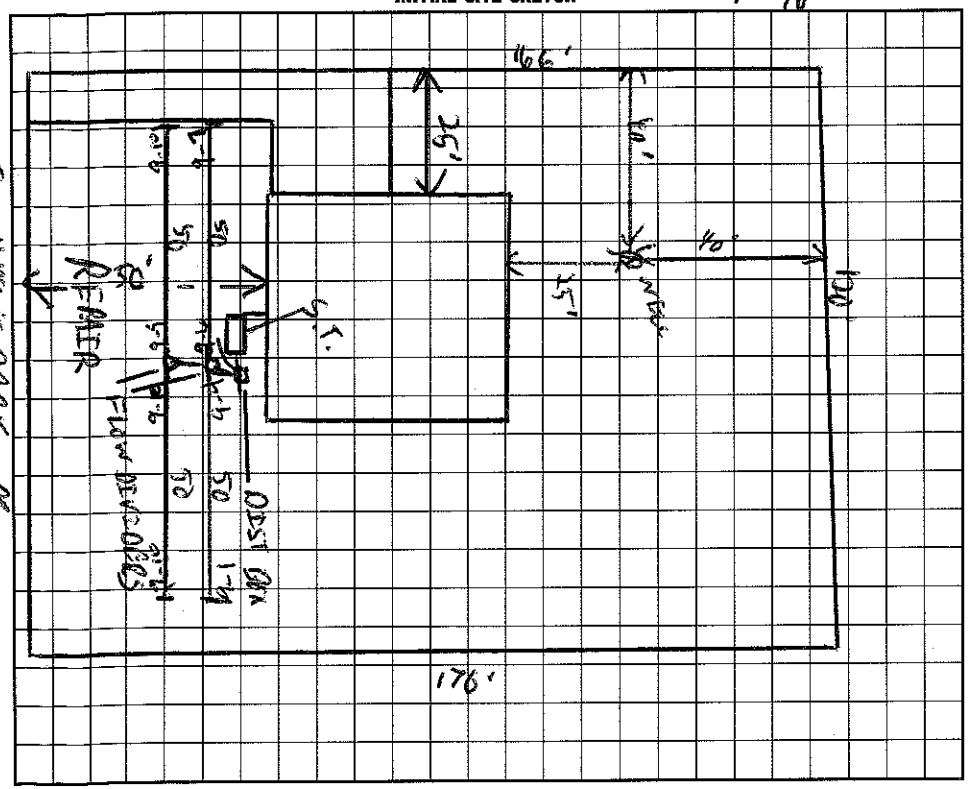

AS BUILT SKETCH

I understand that this permit can be suspended or revoked if any false information is supplied toward securing the permit/any unauthorized changes are made to the site/any unauthorized changes are made in the installation of the system.

Signed: John Collier Jr.

Improvement Permit by: C. R. Thomas EHS date 10/30/96

~~Existing System Inspection by:~~ AUTHORIZATION C. R. Thomas EHS date 10/30/96

Installed by: A-1 Backhoe

Certificate of Completion by: ____ date ____

Operation Permit by: Wesley Sparks RS. date 9/25/98

CO INSTALLER HEALTH DEPT. COPY: WHITE INSPECTION COPY (FINAL): GREEN OWNER COPY (FINAL): YELLOW INSPECTION COPY (INITIAL): PINK OWNER COPY (INITIAL): GOLD