IREDELL COUNTY HEALTH DEPARTMENT

Authorization to Construct

STATESVILLE 704-878-5305 MOORESVILLE 704-664-5281

IMPROVEMENT PERMIT / ~~CERTIFICATE OF COMPLETION~~ / OPERATION PERMIT / EXISTING SYSTEM INSPECTION

PROPERTY DESCRIPTION NO. 23830 DATE 5/14/96 TAX MAP NO. 26-8-53 Watershed: ☑ Yes ☐ No

OWNER OR CONTRACTOR Ray Short Jr. ~~PHONE: Business~~ 463-50-5070 Home 664-6761

ADDRESS 317 Commodore Dr. Mooresville NC 28115

LOCATION Stutts Rd - After Baywatch 3rd lot on pt.

SUBDIVISION Marina Village BLOCK / SECTION ____ LOT 55 LOT AREA ____ SITE CLASS PS DESIGN FLOW 360gal L.T.A.R. .3gal/ft²

Septic Tank: 1000 Gallons; STB 620 Date 4/15/96

Pump Tank: ____ Gallons; PT ____ Date ____

Pump Make: ____ Model ____ Serial No. ____

Nitrification Field: No Fields 1 Square Feet 600 Linear Feet 200

No Lines 3 Trench Width 24" Max Trench Bottom Depth 36" Gravel Depth N/A

☑ New System ☐ Repair System Type: I, II, III, IV, V, VI

System Description: Gravity Panel

Repair System Description: Pump Panel

Maintenance Agreement Required: ☐ Yes ☑ No

☑ House/Mod. Home ☐ Mobile Home ☐ Business ☐ Other

No. Bedrooms 3 No. Bathrooms 2 No. Employees ____


☑ Slab ☐ Crawl Space ☐ Basement w/plumbing ☐ Basement wo/plumbing

Water Supply: ☑ Individual ☐ Community ☐ Public

Comments: GARAGE TIED INTO SEPTIC SYSTEM. ONLY ONE BATHROOM AND NO BEDROOMS IN GARAGE. 8/14/96 C.B.F. *

Comments:

INITIAL SITE SKETCH 1"=40'

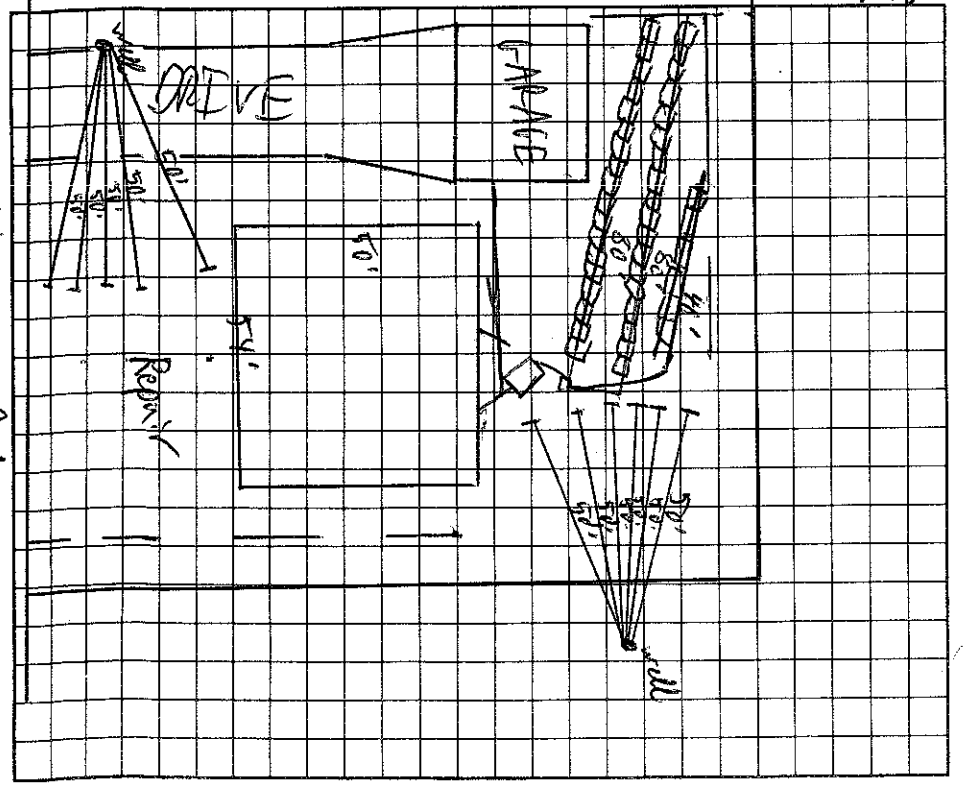

Stutts Rd

AS BUILT SKETCH

Same as site Sketch

I understand that this permit can be suspended or revoked if any false information is supplied toward securing the permit/any unauthorized changes are made to the site/any unauthorized changes are made in the installation of the system.

Signed: Ray Short

Improvement Permit by: C. Rudy Freeman EHSI date 5/14/96

Authorization to Construct ~~Existing System Inspection~~ by: C. Rudy Freeman EHSI date 5/14/96

Installed by: V&S Septic

Certificate of Completion by: ____ date ____

Operation Permit by: C. Rudy Freeman EHSI date 10/3/96

HEALTH DEPT. COPY: WHITE INSPECTION COPY (FINAL): GREEN OWNER COPY (FINAL): YELLOW INSPECTION COPY (INITIAL): PINK OWNER COPY (INITIAL): GOLD

Authorization to Construct is valid for 60 months from issue date