IREDELL COUNTY HEALTH DEPARTMENT

AUTHORIZATION TO CONSTRUCT

4636505621

STATESVILLE 704-878-5305 MOORESVILLE 704-664-5281

IMPROVEMENT PERMIT / ~~CERTIFICATE OF COMPLETION~~ / OPERATION PERMIT / EXISTING SYSTEM INSPECTION

PROPERTY DESCRIPTION NO. 24126 DATE 3/20/97 TAX MAP NO. 26-7-A-245 Watershed: ☑ Yes ☐ No

OWNER OR CONTRACTOR RANDY BAKER PHONE: Business Home 663-1532

ADDRESS 775 McKENDREE RD. MOORESVILLE NC 28115

LOCATION BRAWLEY SCHOOL RD - TL STUTTS - TR MARINA LN, 4TH LOT ON LT.

SUBDIVISION SURFWOOD PK BLOCK / SECTION LOT 245 LOT AREA SITE CLASS. PS DESIGN FLOW 240GPD L.T.A.R. .3 GPD/FT²

Septic Tank: 1000 Gallons; STB 794 Date 7/1/98

Pump Tank: Gallons; PT Date

Pump Make: Model Serial No.

Nitrification Field: No Fields 1 Square Feet 600 Linear Feet 200

No Lines 5 @ 40' Trench Width 36" Max Trench Bottom Depth 36" Gravel Depth N/A

☑ New System ☐ Repair System Type: I, II, III, IV, V, VI

System Description: GRAVITY CHAMBERED ORSIM

Repair System Description: PUMP PANEL

Maintenance Agreement Required: ☐ Yes ☑ No

☑ House/Mod. Home ☐ Mobile Home ☐ Business ☐ Other

No. Bedrooms 3 No. Bathrooms 2 No. Employees


☐ Slab ☑ Crawl Space ☐ Basement w/plumbing ☐ Basement wo/plumbing

Water Supply: ☐ Individual ☑ Community ☐ Public

Comments:

Comments:

INITIAL SITE SKETCH 1"=40'

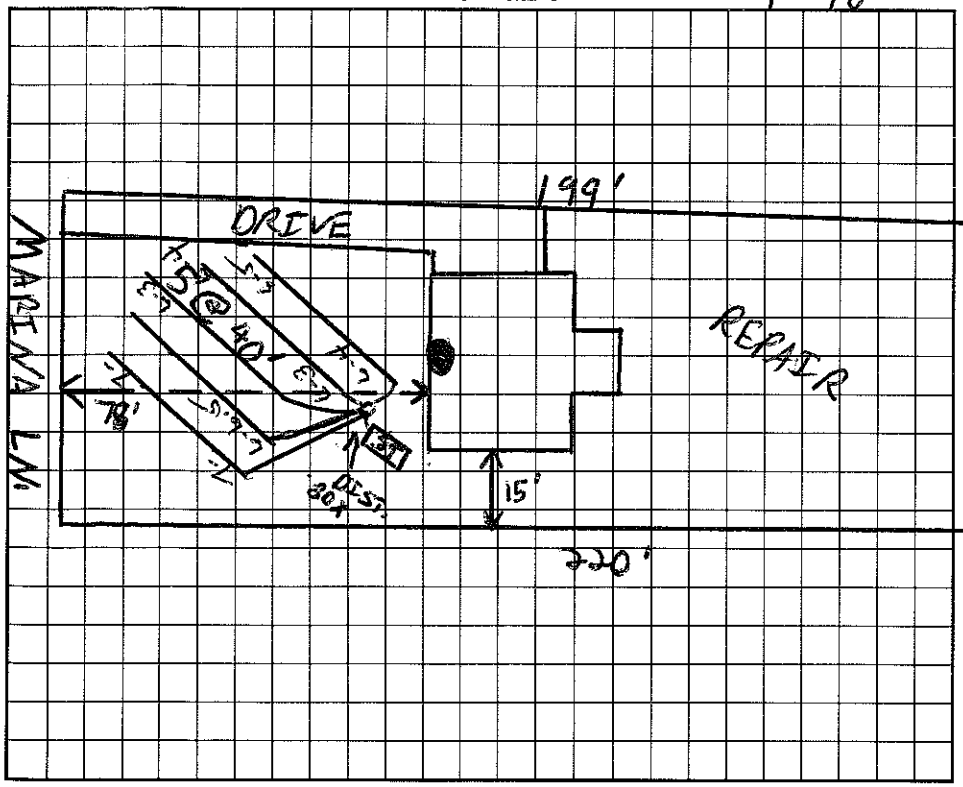

AS BUILT SKETCH

I understand that this permit can be suspended or revoked if any false information is supplied toward securing the permit/any unauthorized changes are made to the site/any unauthorized changes are made in the installation of the system. ~~Improvement Permit~~ is valid for 60 months from date of issuance.

Signed: 1/26/98

Improvement Permit by: EHSI date 3/20/97

AUTHORIZATION TO CONSTRUCT ~~Existing System Inspection~~ by: EHSI date 3/20/97

Installed by: Atlantic Excavating

Certificate of Completion by: date

Operation Permit by: Wesley Sparks RS date 10/2/98

HEALTH DEPT. COPY: WHITE INSPECTION COPY (FINAL): GREEN OWNER COPY (FINAL): YELLOW INSPECTION COPY (INITIAL): PINK OWNER COPY (INITIAL): GOLD