IREDELL COUNTY HEALTH DEPARTMENT

STATESVILLE 704-878-5305 MOORESVILLE 704-664-5281

IMPROVEMENT PERMIT / CERTIFICATE OF COMPLETION / OPERATION PERMIT / EXISTING SYSTEM INSPECTION

PROPERTY DESCRIPTION NO. 1673 DATE August 17, '93 TAX MAP NO. 2G7A 309

OWNER OR CONTRACTOR Robert French PHONE: Business 4636-50-6729 Home

ADDRESS PO Box 1113 Mooresville

LOCATION Lot 1 & 1/2 off Marina Lane on Right

SUBDIVISION Commodore Pen, BLOCK / SECTION LOT 309 LOT AREA 70' x 143' SITE CLASS. PS per 1956 L.T.A.R. .3 gal/ft²/day

Water Supply: ☐ Individual ☑ Community ☐ Public

Septic Tank: 1000 Gallons; STB 525 Date 8/1/93

Pump Tank: Gallons; PT Date

Nitrification Field: No. Fields 1 Square Feet Linear Feet 200

No. Lines 4 Trench Width 24" Trench Depth 28-30" Gravel Depth NA

☐ New System ☐ Repair System Type: I, II, III, IV, V, VI

System Description: gravity LPPBPS

Repair System Description LPPBPS

Maintenance Agreement Required: ☐ Yes ☑ No

☑ House/Mod. Home ☐ Mobile Home ☐ Business ☐ Other

No. Bedrooms 3 No. Bathrooms 2 No. Employees

☐ Slab ☑ Crawl Space ☐ Basement w/plumbing ☐ Basement wo/plumbing

Garbage Disposal: ☐ Yes ☑ No


Auto. Dishwasher: ☑ Yes ☐ No

Auto. Washing Machine: ☑ Yes ☐ No

Other

Comments Maintenance agreement required on future LPPBPS repair.

INITIAL SITE SKETCH

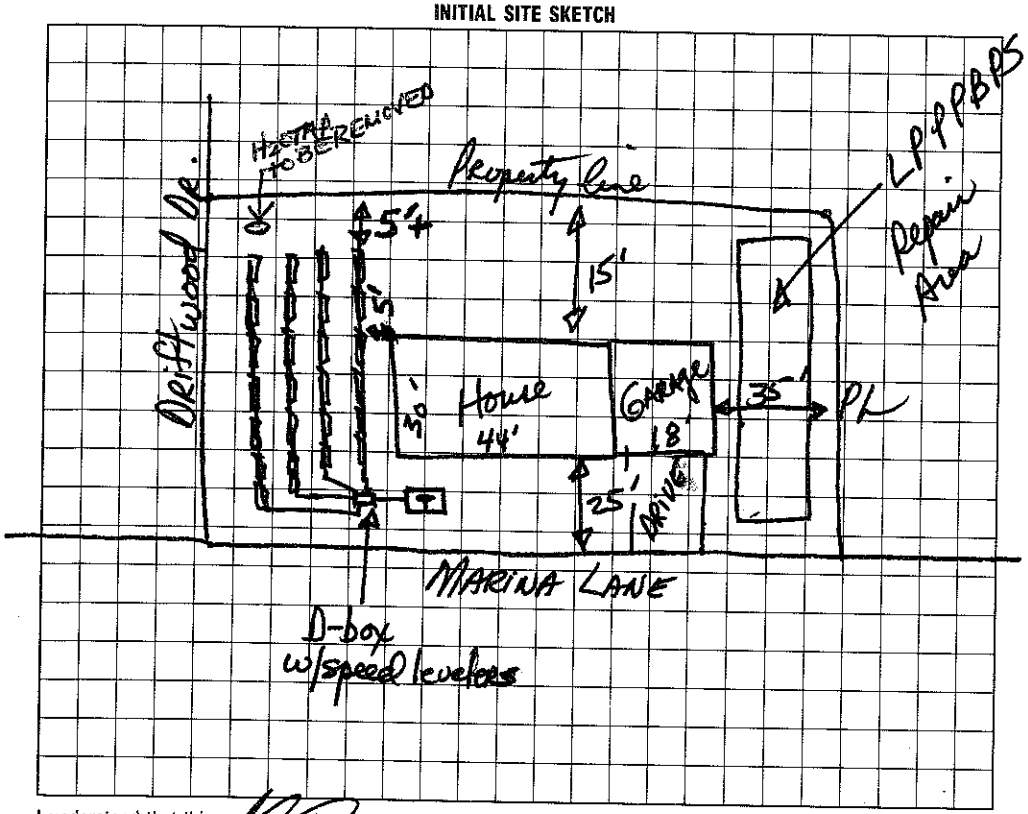

AS BUILT SKETCH

Installed as drawn

I understand that this permit can be suspended or revoked if any false information is supplied toward securing the permit/any unauthorized changes are made to the site/any unauthorized changes are made in the installation of the system. Improvement Permit is valid for 60 months from date of issuance.

Signed:

Improvement Permit by: Jack R. Hinson, RS date 8/17/93

Existing System Inspection by: date

Installed by: Myers Septic Tank Co.

Certificate of Completion by: Wesley Sparkman, Sr. date 9/29/93

Operation Permit by: date

HEALTH DEPT. COPY: WHITE INSPECTION COPY (FINAL): GREEN OWNER COPY (FINAL): YELLOW INSPECTION COPY (INITIAL): PINK OWNER COPY (INITIAL): GOLD