2 30

IREDELL COUNTY HEALTH DEPARTMENT

STATESVILLE 704-878-5305 MOORESVILLE 704-664-5281

IMPROVEMENT PERMIT / CERTIFICATE OF COMPLETION / OPERATION PERMIT / EXISTING SYSTEM INSPECTION

PROPERTY DESCRIPTION NO. 068852 DATE Aug 15, '97 TAX MAP NO. 4636 50 7050 Watershed: ☑ Yes ☐ No

OWNER OR CONTRACTOR Ray Short PHONE: Business _____ Home _____

ADDRESS 470 Stutts Rd. Mooresville

LOCATION Stutts Rd TL 2nd Commodore Loop immediately on left

SUBDIVISION Commodore Pen - BLOCK / SECTION _____ LOT 134 LOT AREA ~ 80 X 143' SITE CLASS. PS DESIGN FLOW 360 gpd L.T.A.R. .3

Septic Tank: 1000 Gallons; STB 794 Date 10/16/97

Pump Tank: _____ Gallons; PT _____ Date _____

Pump Make: _____ Model _____ Serial No. _____

Nitrification Field: No Fields 1 Square Feet 400 Linear Feet 200

No Lines 4@50' Trench Width 24" Max Trench Bottom Depth ~30" Gravel Depth N/A

☑ New System ☐ Repair System Type: I, II, (III), IV, V, VI

System Description: gravity panel block

Repair System Description: same

Maintenance Agreement Required: ☐ Yes ☑ No

☑ House/Mod. Home No. Bedrooms 3

☐ Mobile Home No. Bathrooms 2

☐ Business No. Employees _____

☐ Other _____

☐ Slab ☑ Crawl Space ☐ Basement w/plumbing ☐ Basement wo/plumbing


Water Supply: ☐ Individual ☑ Community ☐ Public

Comments: Lot preexisting

Comments:

1"=30'

INITIAL SITE SKETCH

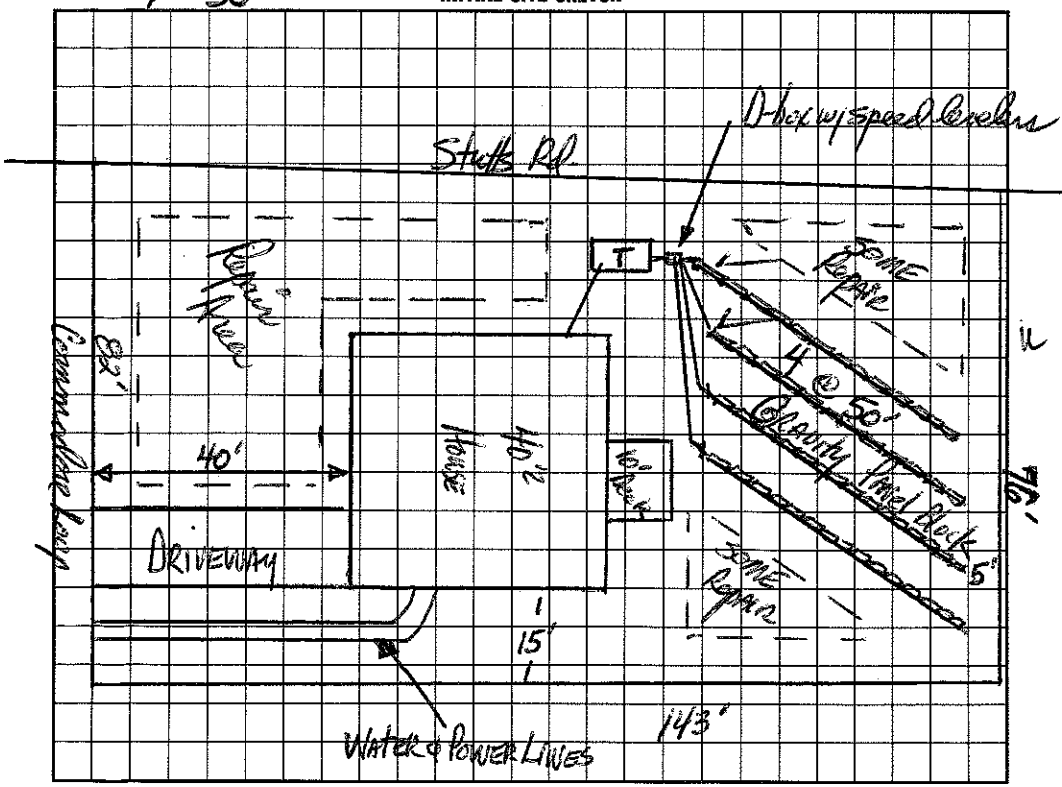

AS BUILT SKETCH

I understand that this permit can be suspended or revoked if any false information is supplied toward securing the permit/any unauthorized changes are made to the site/any unauthorized changes are made in the installation of the system. Improvement Permit is valid for 60 months from date of issuance.

Signed: X R. Short

Improvement Permit by: D.R. Hamm, RS date 8-15-97

~~Existing System Inspection by~~ Construction Authorization: D.R. Hamm, RS date 8-15-97

Installed by: F J Ervin

Certificate of Completion by: Wesley Sparks RS. date 1/22/98

Operation Permit by: Wesley Sparks RS. date 1/22/98

HEALTH DEPT. COPY: WHITE INSPECTION COPY (FINAL): GREEN OWNER COPY (FINAL): YELLOW INSPECTION COPY (INITIAL): PINK OWNER COPY (INITIAL): GOLD