IREDELL COUNTY HEALTH DEPARTMENT Cert Auth STATESVILLE 704-878-5305 MOORESVILLE 704-664-5281

IMPROVEMENT PERMIT / ~~CERTIFICATE OF COMPLETION~~ / OPERATION PERMIT / EXISTING SYSTEM INSPEC.

PROPERTY DESCRIPTION NO. DB 857 DATE Aug 14 '97 TAX MAP NO. 4636 50 8021 Watershed: ☑ Yes ☐ No

OWNER OR CONTRACTOR Ray Shoaf PHONE: Business _____ Home _____

ADDRESS 470 Stutts Rd. Mooresville

LOCATION Brawley School Rd. TR Stutts Rd. TL 2nd Commodore 2nd Lot on Lft

SUBDIVISION Commodore Rev. BLOCK / SECTION _____ LOT 33 LOT AREA 80'X143 SITE CLASS. RS DESIGN FLOW 360gpd L.T.A.R. .3

Septic Tank: 1000 Gallons; STB 794 Date 10/7/96

Pump Tank: _____ Gallons; PT _____ Date _____

Pump Make: _____ Model _____ Serial No. _____

Nitrification Field: No Fields 1 Square Feet 400 Linear Feet 200

No Lines 4@50' Trench Width 24" Max Trench Bottom Depth ~30" Gravel Depth _____

☑ New System ☐ Repair System Type: I, II, (III), IV, V, VI

System Description: gravity panel block

Repair System Description: same

Maintenance Agreement Required: ☐ Yes ☑ No

☑ House/Mod. Home No. Bedrooms 3

☐ Mobile Home No. Bathrooms ____

☐ Business No. Employees ____

☐ Other _____

☑ Slab ☑ Crawl Space ☐ Basement w/plumbing ☐ Basement wo/plumbing


Water Supply:
☐ Individual
☑ Community
☐ Public

Comments: Lot preexisting to July 1977

Comments:

1" = 30'

INITIAL SITE SKETCH

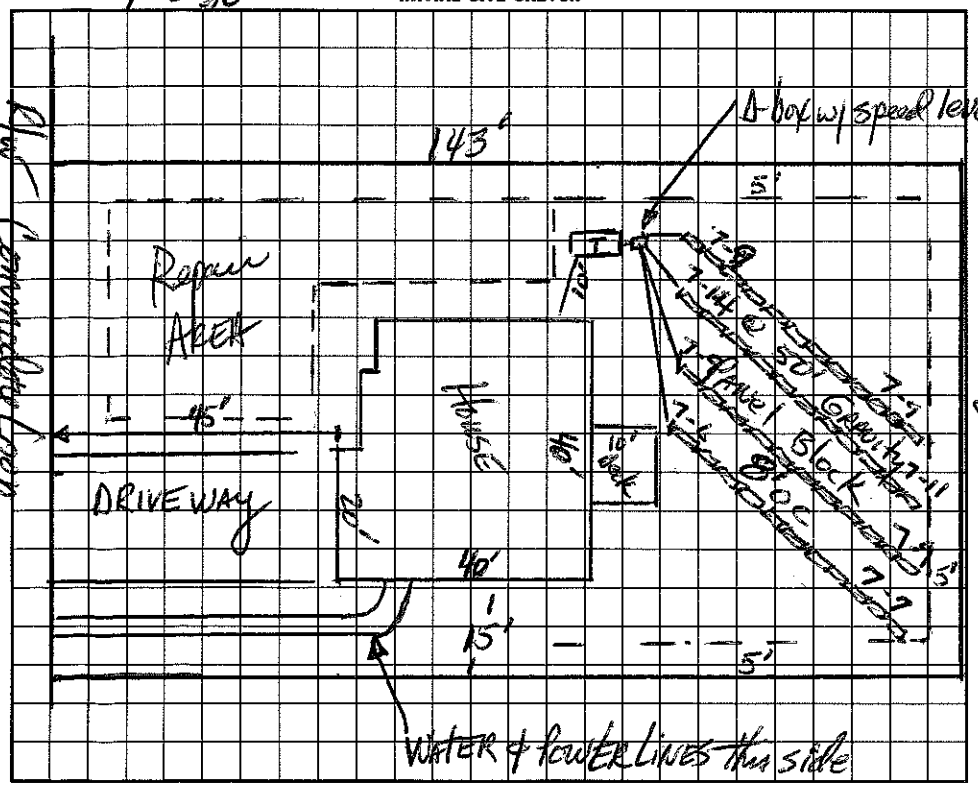

AS BUILT SKETCH

I understand that this permit can be suspended or revoked if any false information is supplied toward securing the permit/any unauthorized changes are made to the site/any unauthorized changes are made in the installation of the system. Improvement Permit is valid for 60 months from date of issuance.

Signed: X Ray Shoaf

Improvement Permit by: D R Hamm RS date 8-14-97

Constructed ~~Existing System Inspection by:~~ D R Hamm RS date 8-14-97

Authorized

Installed by: F J Erwin

Certificate of Completion by: Wesley Sparks RS. date 1/21/98

Operation Permit by: Wesley Sparks RS date 1/21/98

HEALTH DEPT. COPY: WHITE INSPECTION COPY (FINAL): GREEN OWNER COPY (FINAL): YELLOW INSPECTION COPY (INITIAL): PINK OWNER COPY (INITIAL): GOLD