4:00

IREDELL COUNTY HEALTH DEPARTMENT Const. Auth. STATESVILLE 704-878-5305 MOORESVILLE 704-664-5281

IMPROVEMENT PERMIT / ~~CERTIFICATE OF COMPLETION~~ / OPERATION PERMIT / EXISTING SYSTEM INSPECTION

PROPERTY DESCRIPTION NO. 068850 DATE August 11, '97 TAX MAP NO. 4636 509 001 Watershed: ☑ Yes ☐ No

OWNER OR CONTRACTOR Ray Shoat PHONE: Business 529-3430 Home

ADDRESS 470 Stutts Rd. Mooresville 4636-50-9001

LOCATION Stutts Rd. TR 2nd Commodore Loop 3rd Lot on left

SUBDIVISION Commodore Est. BLOCK / SECTION LOT 132 LOT AREA 80'x143 SITE CLASS. #5 per 1572 DESIGN FLOW 360gpd L.T.A.R. .3

Septic Tank: 1000 Gallons; STB 799 Date 10/1/97

Pump Tank: Gallons; PT Date

Pump Make: Model Serial No.

Nitrification Field: No. Fields 1 Square Feet 400 Linear Feet 200

No Lines 4@50' Trench Width 24" Max Trench Bottom Depth 36" Gravel Depth NA

☑ New System ☐ Repair System Type: I, II, III, IV, V, VI

System Description: gravity panel block

Repair System Description: same

Maintenance Agreement Required: ☐ Yes ☑ No

☑ House/Mod. Home No. Bedrooms 3

☐ Mobile Home No. Bathrooms 2

☐ Business No. Employees

☐ Other

☐ Slab ☑ Crawl Space ☐ Basement w/plumbing ☐ Basement wo/plumbing


Water Supply: ☐ Individual ☑ Community ☐ Public

Comments: Lot preexisting to July 1977

Comments:

1"=30'

INITIAL SITE SKETCH

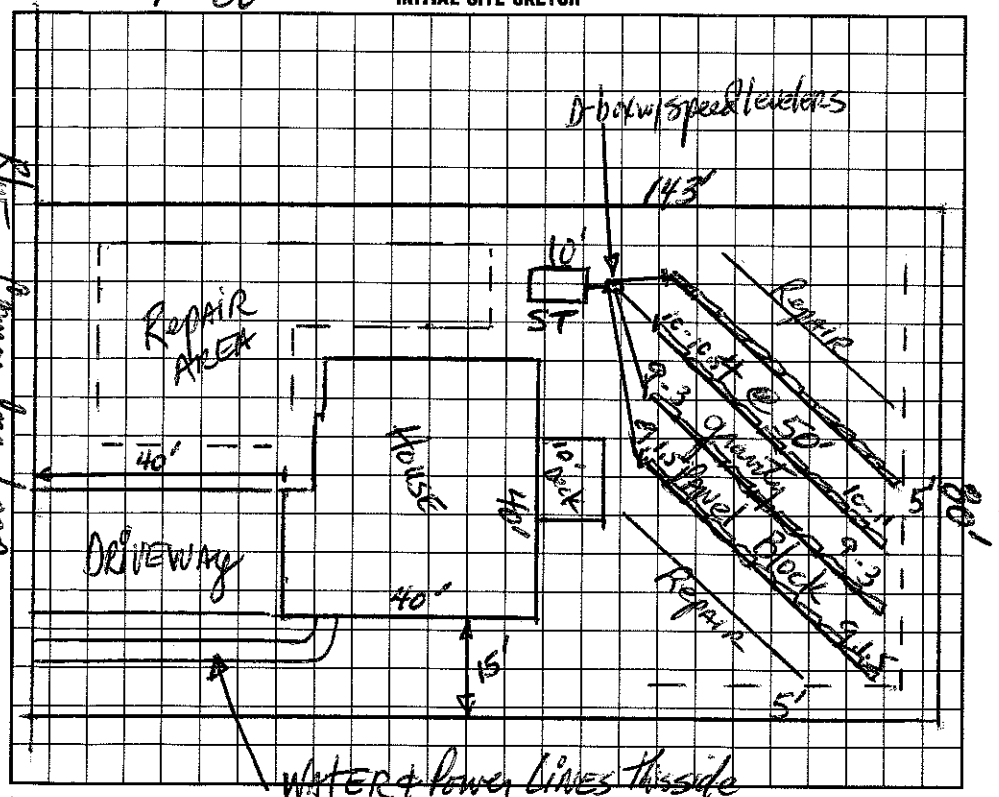

AS BUILT SKETCH

Installed as shown on Auth To Construct

I understand that this permit can be suspended or revoked if any false information is supplied toward securing the permit/any unauthorized changes are made to the site/any unauthorized changes are made in the installation of the system. Improvement Permit is valid for 60 months from date of issuance.

Signed: Ray Shoat

Improvement Permit by: [signature] RS date 8-11-97

~~Construction Authorization~~ ~~Existing System Inspection~~ by: [signature] RS date 8-11-97

Installed by: F J Erwin

Certificate of Completion by: Wesley Sparks RS. date 1/15/98

Operation Permit by: Wesley Sparks RS. date 1/15/98

HEALTH DEPT. COPY: WHITE INSPECTION COPY (FINAL): GREEN OWNER COPY (FINAL): YELLOW INSPECTION COPY (INITIAL): PINK OWNER COPY (INITIAL): GOLD