IREDELL COUNTY HEALTH DEPARTMENT

STATESVILLE 704-878-5305 MOORESVILLE 704-664-5281

IMPROVEMENT PERMIT / CERTIFICATE OF COMPLETION / OPERATION PERMIT / EXISTING SYSTEM INSPECTION

PROPERTY DESCRIPTION NO. Cynthia Mullis DATE 5/4/94

OWNER OR CONTRACTOR (Tenant Peter Christenbury) TAX MAP NO.

ADDRESS 429 Stutts Road Mooresville PHONE: Business (201) 743-2164 Home Watershed: ☐ Yes ☐ No

LOCATION 1000 L from Stutts, On Lt before Water Tank 4636-50-9786

SUBDIVISION Commodore BLOCK / SECTION 1 LOT 2(??) LOT AREA SITE CLASS. DESIGN FLOW L.T.A.R.

Septic Tank: Exist Gallons; STB Date

Pump Tank: 0 Gallons; PT Date

Pump Make: Model Serial No.

Nitrification Field: No Fields 1 Square Feet 200' Linear Feet 100' RPBPS

No Lines 2 Trench Width 24" Max Trench Bottom Depth Gravel Depth N/A

☐ New System ☑ Repair System Type: I, II, III, IV, V, VI

System Description: PPBPS Gravity

Repair System Description:

Maintenance Agreement Required: ☐ Yes ☑ No

☑ House/Mod. Home No. Bedrooms 3

☐ Mobile Home No. Bathrooms 2

☐ Business No. Employees

☐ Other


☑ Slab ☐ Crawl Space ☐ Basement w/plumbing ☐ Basement wo/plumbing

Water Supply: ☐ Individual ☑ Community ☐ Public


Comments: Add 100' of New 16" Tej Pane Ditches - Add 50' from new line out of "D" Box, Add other 50' at end of old lines as shown. Feed new line from Box first, then line nearest house, feed extended line last.

Comments:

INITIAL SITE SKETCH

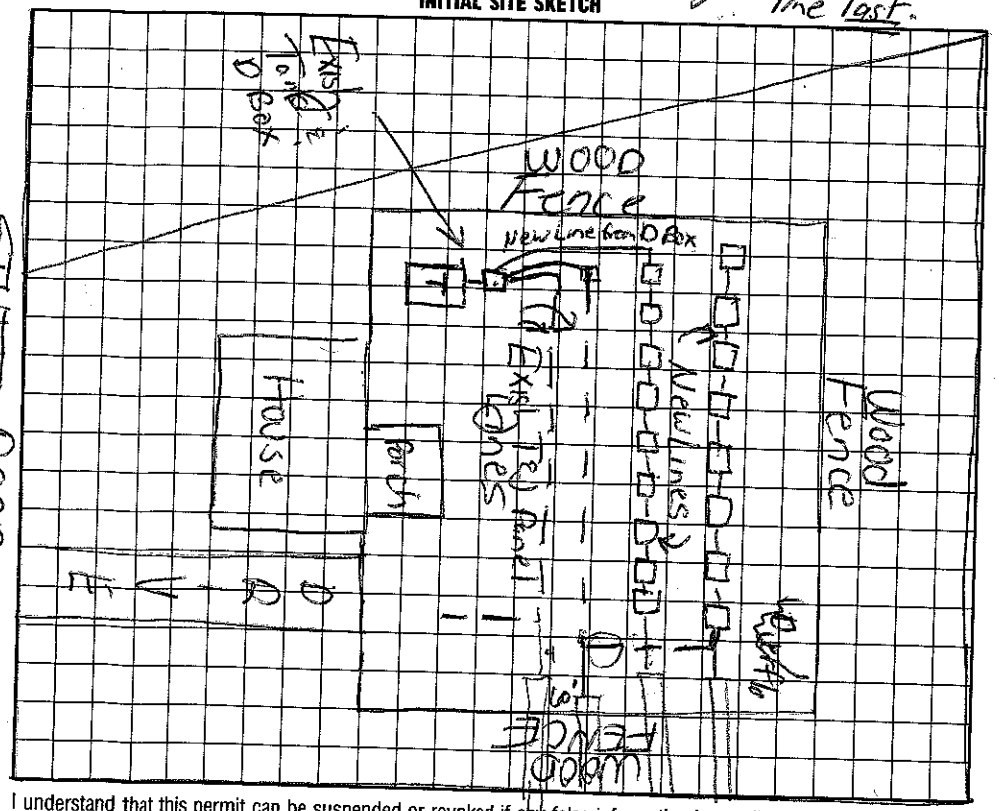

AS BUILT SKETCH

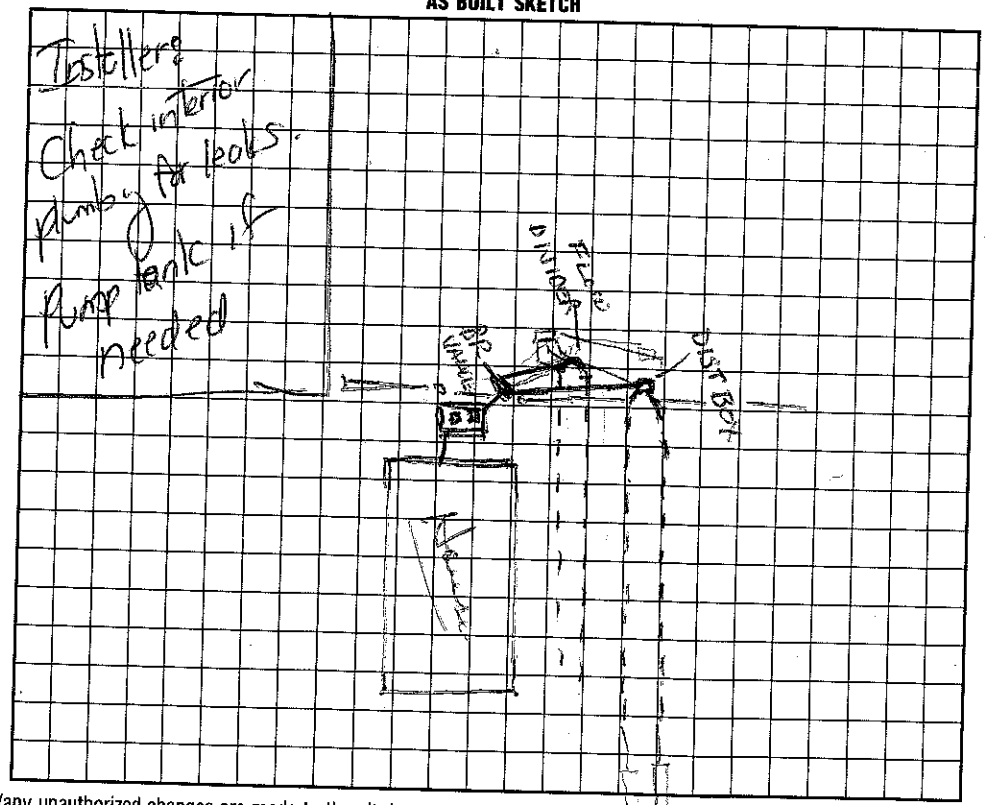

I understand that this permit can be suspended or revoked if any false information is supplied toward securing the permit/any unauthorized changes are made to the site/any unauthorized changes are made in the installation of the system. Improvement Permit is valid for 60 months from date of issuance.

Signed: David Mooney

Improvement Permit by: date 5/4/95

Existing System Inspection by: date

Installed by: Richard Abernathy

Certificate of Completion by: Wesley Sparks R.S. date 10/9/95

Operation Permit by: Wesley Sparks R.S. date 10/9/95

HEALTH DEPT. COPY: WHITE INSPECTION COPY (FINAL): GREEN OWNER COPY (FINAL): YELLOW INSPECTION COPY (INITIAL): PINK OWNER COPY (INITIAL): GOLD