IREDELL COUNTY HEALTH DEPARTMENT

STATESVILLE 704-878-5305 $315.00 Paid 3.00 MOORESVILLE 704-664-5281

IMPROVEMENT PERMIT / AUTHORIZATION TO CONSTRUCT / OPERATION PERMIT / EXISTING SYSTEM INSPECTION

PERMIT# 125830 PIN# 4636-51-3393 DATE 2/21/05

OWNER OR CONTRACTOR Spear Bldrs, Inc PHONE: Business 704 202 4964 Home

ADDRESS 192 Wildwood Cove Dr. Mooresville NC 28117

LOCATION BSR, TL Stutts, TR Blue Wing, on Rt 128 Bluewing Ln.

SUBDIVISION Commodore Pen. BLOCK / SECTION LOT 295 LOT AREA 0.22 AC SITE CLASS. PS DESIGN FLOW 360 L.T.A.R. 0.3

Septic Tank: 1000 Gallons; STB 825 Date 2/19/05
Pump Tank: 1000 Gallons; PT 362 Date 2/9/05
Pump Make: Zoeller Model W137-C Serial No.
Nitrification Field: No Fields 1 Square Feet 400 Linear Feet 200
No Lines 3 Trench Width 24" Max Trench Bottom Depth 32" Gravel Depth —

☒ New System ☐ Repair System Type: I, II, III, (IV), V, VI
System Description: LP Pond Block
Repair System Description: Limited - Deed Restriction
Maintenance Agreement Required: ☒ Yes ☐ No to 1985

☒ House/Mod. Home No. Bedrooms 3
☐ Mobile Home No. Bathrooms
☐ Business No. Employees
☐ Other

☐ Slab ☒ Crawl Space ☐ Basement w/plumbing ☐ Basement wo/plumbing

Water Supply: ☐ Individual ☐ Public ☒ Community


Comments:/Conditions: Can go to 5' of Property line if needed

1" = 40'

Comments:/Conditions:

45 3/16" Panels

INITIAL SITE SKETCH

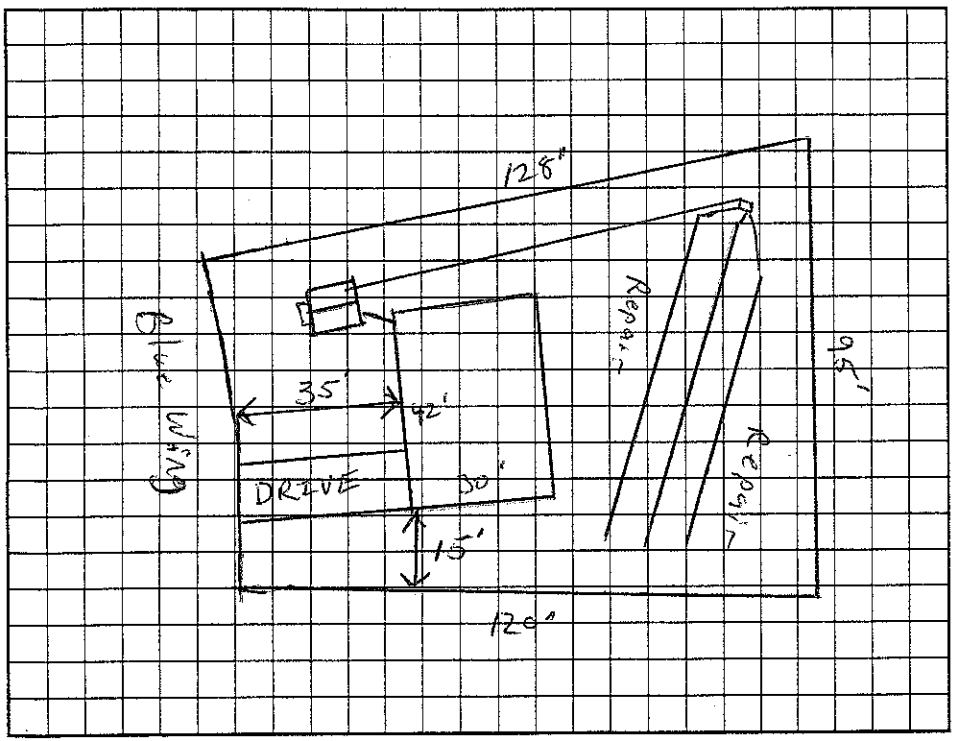

AS BUILT SKETCH

Permit can be suspended or revoked if any false information is supplied toward securing the permit/any unauthorized changes are made to the site/any unauthorized changes are made in the installation of the system. Improvement Permit with plat valid without expiration. Improvement Permit with site plan valid for sixty months. Authorization to Construct is valid for a period equal to that of Improvement Permit – not to exceed sixty months.

Signed: date 2/21/05 Installed by: Rowan Septic

Improvement Permit by: RS date 2/21/05 Operation Permit by: Wesley Sparks RS. date 5/3/05

Authorization to Construct by: RS date 2/21/05 Existing System Inspection by: date

HEALTH DEPT. COPY: WHITE OWNER COPY (FINAL): YELLOW OWNER COPY (INITIAL): PINK