IREDELL COUNTY HEALTH DEPARTMENT

STATESVILLE 704-878-5305 130.00 Paid MOORESVILLE 704-664-5281

IMPROVEMENT PERMIT / AUTHORIZATION TO CONSTRUCT / OPERATION PERMIT / EXISTING SYSTEM INSPECTION

PERMIT# 125829 PIN# 4636514366 DATE 2/17/05

OWNER OR CONTRACTOR Speer Riders, Inc. PHONE: Business 704-202-7964 Home

ADDRESS 192 Wildwood Cove Ct. Mooresville NC 28117

LOCATION BSR, TL Stutts, TR Blue Wing, on Rt.

SUBDIVISION Commodore Pen BLOCK / SECTION LOT 296 LOT AREA 0.259 AC SITE CLASS. RS DESIGN FLOW 360 L.T.A.R. 0.3

Septic Tank: 1000 Gallons: STB 823 Date 2/20/05

Pump Tank: 1000 Gallons: PT 302 Date 4/28/05

Pump Make: Zoeller Model N153 Serial No.

Nitrification Field: No Fields 1 Square Feet 600 sq Linear Feet 200

No Lines 4 @ 50 Trench Width 24" Max Trench Bottom Depth 36" Gravel Depth —

☒ New System ☐ Repair System Type: I, II, III, IV, V, VI

System Description: PM Panel Block

Repair System Description: Limited - Need Prior

Maintenance Agreement Required: ☐ Yes ☒ No to 1988

☒ House/Mod. Home No. Bedrooms 3

☐ Mobile Home No. Bathrooms

☐ Business No. Employees

☐ Other

☐ Slab ☒ Crawl Space ☐ Basement w/plumbing ☐ Basement wo/plumbing


Water Supply: ☐ Individual ☐ Public ☒ Community

Comments:/Conditions:

1"=40'

Comments:/Conditions:

INITIAL SITE SKETCH

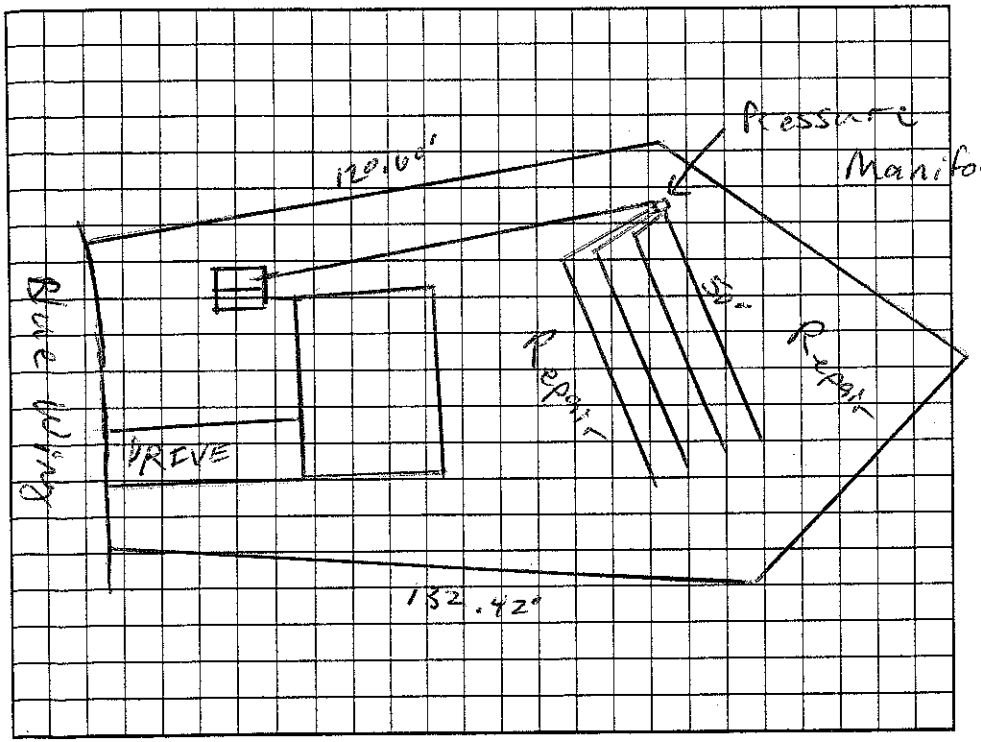

AS BUILT SKETCH

Permit can be suspended or revoked if any false information is supplied toward securing the permit/any unauthorized changes are made to the site/any unauthorized changes are made in the installation of the system. Improvement Permit with plat valid without expiration. Improvement Permit with site plan valid for sixty months. Authorization to Construct is valid for a period equal to that of Improvement Permit – not to exceed sixty months.

Signed: date 2/21/05 Installed by: Rowan Septic

Improvement Permit by: RS date 2/17/05 Operation Permit by: Wesley Speer RS. date 4/29/05

Authorization to Construct by: RS date 2/17/05 Existing System Inspection by: date

HEALTH DEPT. COPY: WHITE OWNER COPY (FINAL): YELLOW OWNER COPY (INITIAL): PINK