IREDELL COUNTY HEALTH DEPARTMENT

Mooresville Phone TR 3-7271 . Mooresville Phone No. 664-5281

PERMIT TO INSTALL SEPTIC TANK

Permit No. 203 Permit Date 8-15- 1973

Owner Mr. Legg Address Charlotte

Installed By F. J. Ervin Address Mooresville


Location of Property 1100 Tb to 1112 1½ mi to Coveview Park Lot 24

Tank		Capacity		Length of Lines		Fixtures	
Block	( )	1000	(✓)	225'	( )	No. of Baths	(2)
Precast	(✓)	1250	( )	250'	( )	Dishwasher	(YES
		1500	( )	Other 240		Garbage Grdr.	(NO
		Other				Other Washing Machine	

NOTIFY HEALTH DEPARTMENT AT LEAST EIGHT HOURS BEFORE TANK IS TO BE INSPECTED.

Final Inspection 8-15- 1973 Approved (✓) Disapproved ( )

Remarks Water System

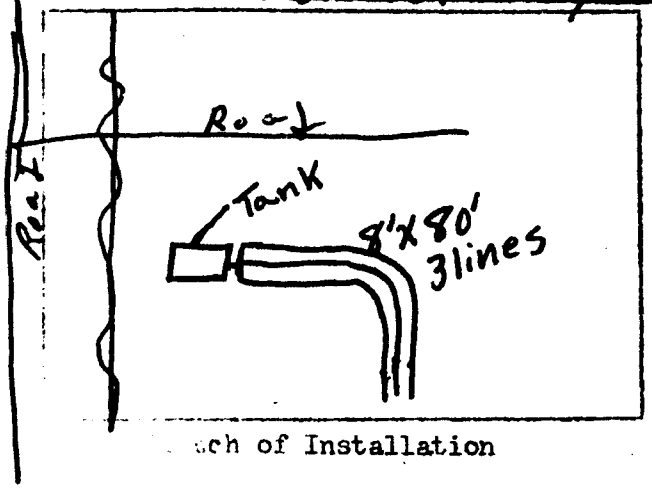

Sketch of Installation

J. C. Moore

Sanitarian