IREDELL COUNTY HEALTH DEPARTMENT

STATESVILLE 704-878-5305 150.00 Paid MOORESVILLE 704-664-5281

IMPROVEMENT PERMIT / AUTHORIZATION TO CONSTRUCT / OPERATION PERMIT / EXISTING SYSTEM INSPECTION

PERMIT# 1160063 PIN# 4623651 6797 DATE 10-13-03

OWNER OR CONTRACTOR Danny Everhart PHONE: Business 664-0621 Home 664-7621

ADDRESS 111 Driftwood Drive Mooresville NC 28117

LOCATION Brawley School Rd TL Stutts TR Cove View TL Driftwood on left

SUBDIVISION Cove View BLOCK / SECTION ____ LOT 19 LOT AREA .34 Acre SITE CLASS. PS DESIGN FLOW 360gpd L.T.A.R. ____

Install

Septic Tank: 1000 Gallons; STB 794 Date 4-13-04

Pump Tank: ____ Gallons; PT ____ Date ____

Pump Make: ____ Model ____ Serial No. ____

Nitrification Field: No Fields ____ Square Feet ____ Linear Feet ____

No Lines ____ Trench Width 15th Max Trench Bottom Depth ____ Gravel Depth ____

X New System ☐ Repair System Type: I, II, III, IV, V, VI

System Description: Gravity-Conventional

Repair System Description: ____

Maintenance Agreement Required: ☐ Yes X No

☐ House/Mod. Home No. Bedrooms 3

X Mobile Home No. Bathrooms 2

☐ Business No. Employees ____

☐ Other ____


☐ Slab ☐ Crawl Space ☐ Basement w/plumbing ☐ Basement wo/plumbing

Water Supply: ☐ Individual X Public X Community

Comments:/Conditions: Existing drainfield appears to be functioning okay at time of inspection. However, New MH will be to close to existing ST therefore New ST will have to be installed.

Comments:/Conditions: Keep New ST at least 5' from MH & keep new MH at least 5' from drainField

INITIAL SITE SKETCH

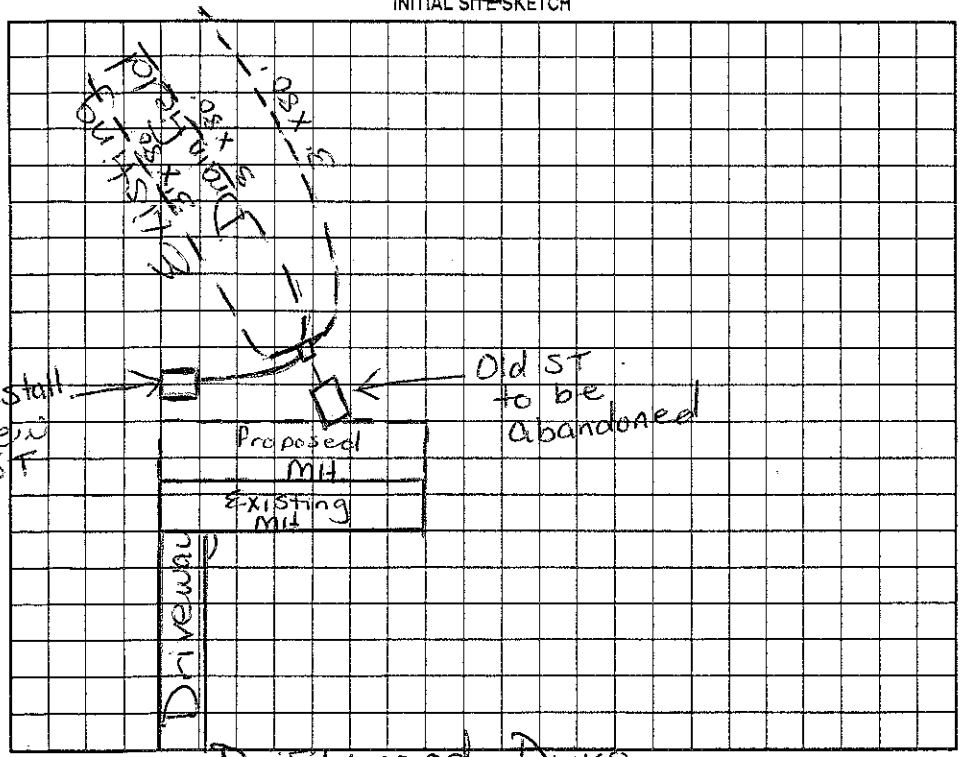

AS BUILT SKETCH

Note: Original Septic System installed in 1984

Installed as Drawn

Used Speed levelers

Permit can be suspended or revoked if any false information is supplied toward securing the permit/any unauthorized changes are made to the site/any unauthorized changes are made in the installation of the system. Improvement Permit with plat valid without expiration. Improvement Permit with site plan valid for sixty months. Authorization to Construct is valid for a period equal to that of Improvement Permit – not to exceed sixty months.

Signed: Danny Everhart date 5-3-04

Improvement Permit by: Maria H. Dawson R.S. date 10/13/03

Authorization to Construct by: Maria H. Dawson date 10/13/03

Installed by: Tim Ammons R.S.

Operation Permit by: Maria H. Dawson R.S. date 5/18/04

Existing System Inspection by: ____ date ____

HEALTH DEPT. COPY: WHITE OWNER COPY (FINAL): YELLOW OWNER COPY (INITIAL): PINK