IREDELL COUNTY HEALTH DEPARTMENT

STATESVILLE 704-878-5305 MOORESVILLE 704-664-5281

IMPROVEMENT PERMIT / AUTHORIZATION TO CONSTRUCT / OPERATION PERMIT / EXISTING SYSTEM INSPECTION

PERMIT# 074743 PIN# 4636518068 DATE 9/10/98

OWNER OR CONTRACTOR ROY EDWARD JONES PHONE: Business Home 663-7039

ADDRESS 127 HAZELTON LP. MOORESVILLE NC 28115

LOCATION BRAWLEY SCHOOL - TL STUTTS - CORNER OF BLUEWING

SUBDIVISION COMMODORE PEN BLOCK / SECTION 2 LOT 315 LOT AREA - SITE CLASS. PS DESIGN FLOW 240 GPD L.T.A.R. .30 PD/FT2

Septic Tank: 1000 Gallons; STB 1012 Date 7/24/98
Pump Tank: 1000 Gallons; PT 17 Date 7/7/98
Pump Make: HYDROWATIC Model SK-60 Serial No. 6/98
Nitrification Field: No Fields 1 Square Feet 540 Linear Feet 180
No Lines 4@45' Trench Width 36" Max Trench Bottom Depth 36" Gravel Depth N/A

☑ New System ☐ Repair System Type: I, II, III, IV, V, VI
System Description: PUMP PANEL
Repair System Description: DEEDED B-4 1983
Maintenance Agreement Required: ☐ Yes ☑ No


☐ House/Mod. Home No. Bedrooms 2
☑ Mobile Home No. Bathrooms 2
☐ Business No. Employees
☐ Other
☐ Slab ☑ Crawl Space ☐ Basement w/plumbing ☐ Basement wo/plumbing

Water Supply: ☑ Individual ☐ Public ☑ Community

Comments:/Conditions: SUPPLY LINE MAY COME TO 5' FROM PROPERTY LINE. TRENCH WIDTH SHALL BE 3 FEET

Comments:/Conditions:

INITIAL SITE SKETCH

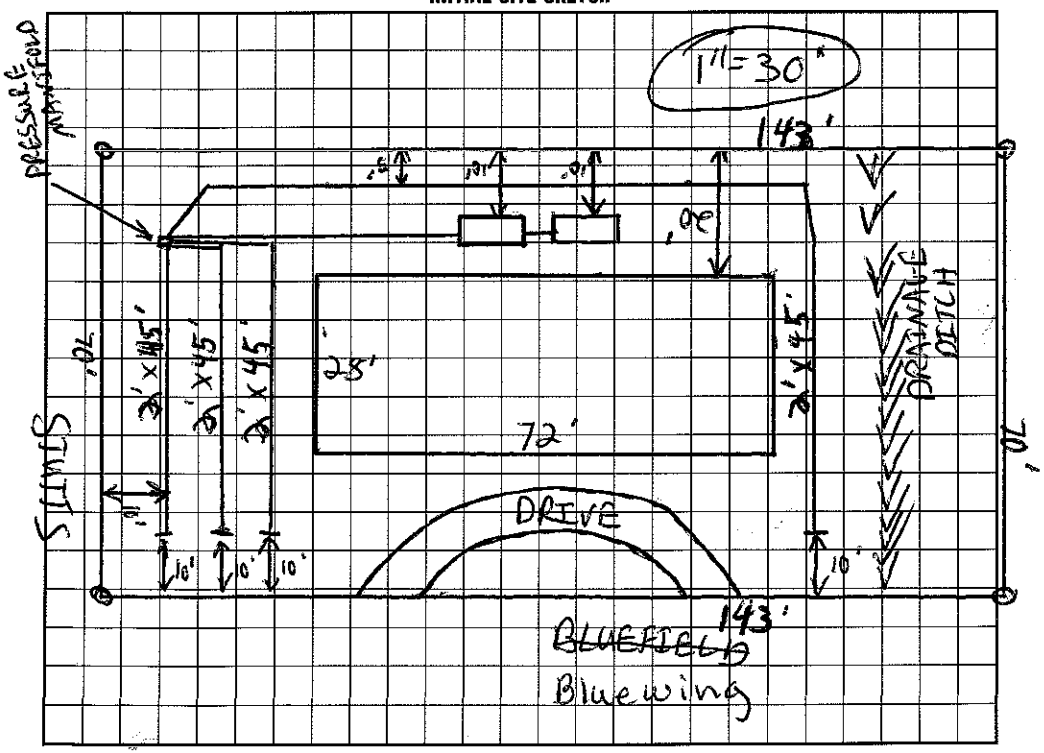

AS BUILT SKETCH

I understand that this permit can be suspended or revoked if any false information is supplied toward securing the permit/any unauthorized changes are made to the site/any unauthorized changes are made in the installation of the system. Improvement Permit with plat valid without expiration. Improvement Permit with site plan valid for sixty months. Authorization to Construct is valid for a period equal to that of Improvement Permit – not to exceed sixty months.

Signed: Debbie Atwell date

Improvement Permit by: C. [signature] RS date 9/10/98

Authorization to Construct by: C. [signature] RS date 9/10/98

Installed by: A-1 Backhoe

Operation Permit by: C. [signature] date 9/14/99

Existing System Inspection by: date

HEALTH DEPT. COPY: WHITE INSPECTION COPY (FINAL): GREEN OWNER COPY (FINAL): YELLOW INSPECTION COPY (INITIAL): PINK OWNER COPY (INITIAL): GOLD