IREDELL COUNTY HEALTH DEPARTMENT

STATESVILLE 704-878-5305 | MOORESVILLE 704-664-5281

IMPROVEMENT PERMIT / AUTHORIZATION TO CONSTRUCT / OPERATION PERMIT / EXISTING SYSTEM INSPECTION

PERMIT# 108540 PIN# 4636 51 9336 DATE 9/9/02

OWNER OR CONTRACTOR Apple Dew, Co, Inc. (DUANE LEWIS) PHONE: Business 704-351-0809 Home

ADDRESS 708 Whistle Pines Rd Mooresville, NC. 28117

LOCATION Stutts Rd. on (R) next to 402

SUBDIVISION Commodore Pen. BLOCK / SECTION 2 LOT 318 LOT AREA .23 SITE CLASS PS DESIGN FLOW 246 L.T.A.R. .3

Septic Tank: 1000 Gallons; STB 821 Date 8/15/02
Pump Tank: Gallons; PT Date
Pump Make: Model Serial No.
Nitrification Field: No Fields 1 Square Feet 400 Linear Feet 200
No Lines 5@40' Trench Width 2-3' Max Trench Bottom Depth 36" Gravel Depth NONE

☒ New System ☐ Repair System Type: I, II, (III), IV, V, VI
System Description: GRAVITY – 16" PPBPS
Repair System Description: RECORDED < 1983
Maintenance Agreement Required: ☐ Yes ☒ No


☒ House/Mod. Home No. Bedrooms 3
☐ Mobile Home No. Bathrooms 2
☐ Business No. Employees
☐ Other
☐ Slab ☒ Crawl Space ☐ Basement w/plumbing ☐ Basement wo/plumbing

Water Supply:
☐ Individual
☐ Public
☒ Community

Comments:/Conditions:

Comments:/Conditions:

INITIAL SITE SKETCH (1" = 30')

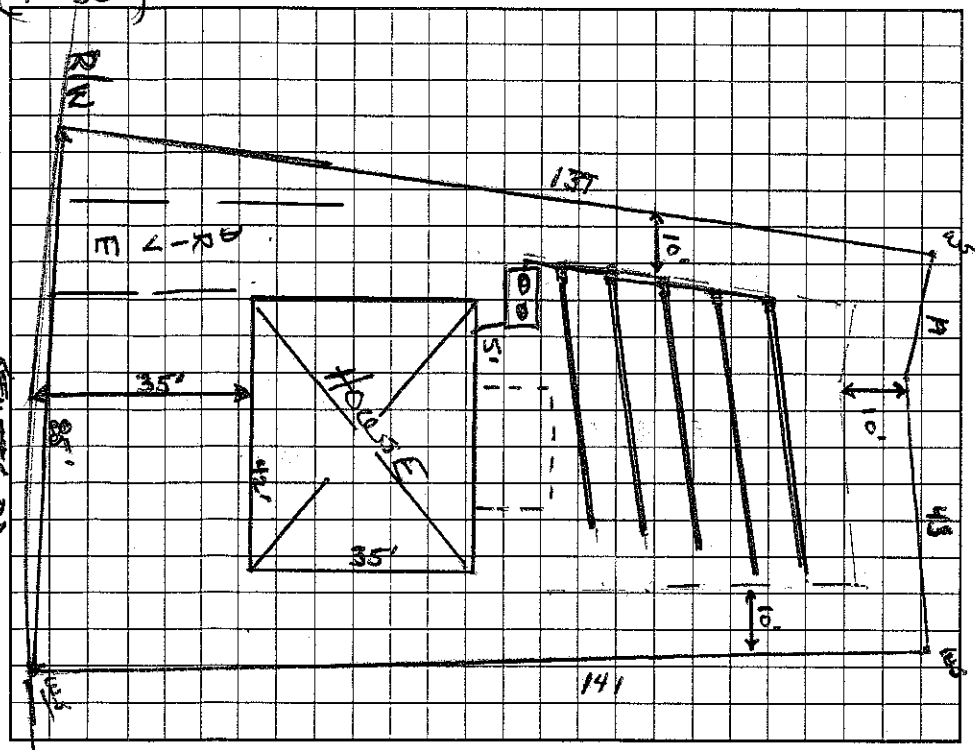

AS BUILT SKETCH

Permit can be suspended or revoked if any false information is supplied toward securing the permit/any unauthorized changes are made to the site/any unauthorized changes are made in the installation of the system. Improvement Permit with plat valid without expiration. Improvement Permit with site plan valid for sixty months. Authorization to Construct is valid for a period equal to that of Improvement Permit – not to exceed sixty months.

Signed: Duane Lewis date 9-11-02 Installed by: Randy Sides

Improvement Permit by: Wesley Sparks RS. date 9/9/02 Operation Permit by: Wesley Sparks RS. date 10/10/02

Authorization to Construct by: Wesley Sparks RS date 9/9/02 Existing System Inspection by: date

HEALTH DEPT. COPY: WHITE OWNER COPY (FINAL): YELLOW OWNER COPY (INITIAL): PINK