IREDELL COUNTY HEALTH DEPARTMENT

STATESVILLE 704-878-5305 MOORESVILLE 704-664-5281

IMPROVEMENT PERMIT / AUTHORIZATION TO CONSTRUCT / OPERATION PERMIT / EXISTING SYSTEM INSPECTION

PERMIT# 078107 PIN# 2G 7A 319 / 4636-51-9424 DATE 12/22/98

OWNER OR CONTRACTOR Duane Lewis PHONE: Business Home 664-3400

ADDRESS 708 Isle Pines Rd. Mooresville, NC. 28117

LOCATION Stutts Rd on (R) before Bluewing Rd.

SUBDIVISION Cove View Park BLOCK / SECTION LOT 319 LOT AREA .32 AC SITE CLASS. PS DESIGN FLOW 360 L.T.A.R. .3

Septic Tank: 1000 Gallons; STB 794 Date 6/21/79
Pump Tank: Gallons; PT Date
Pump Make: Model Serial No.
Nitrification Field: No Fields 1 Square Feet 900* Linear Feet 300*
No Lines 5 Trench Width 36" Max Trench Bottom Depth 36" Gravel Depth SAND.

☒ New System ☐ Repair System Type: I, II, (III), IV, V, VI
System Description: Gen - Ch. Plastic
Repair System Description: 16" PPBS
Maintenance Agreement Required: ☐ Yes ☒ No


☒ House/Mod. Home No. Bedrooms 3
☐ Mobile Home No. Bathrooms 2
☐ Business No. Employees
☐ Other
☐ Slab ☒ Crawl Space ☐ Basement w/plumbing ☐ Basement wo/plumbing

Water Supply: ☐ Individual ☐ Public ☒ Community
CORRITER

Comments:/Conditions: * 25% reduction already calculated install where shown on this permit.

Comments:/Conditions:

INITIAL SITE SKETCH

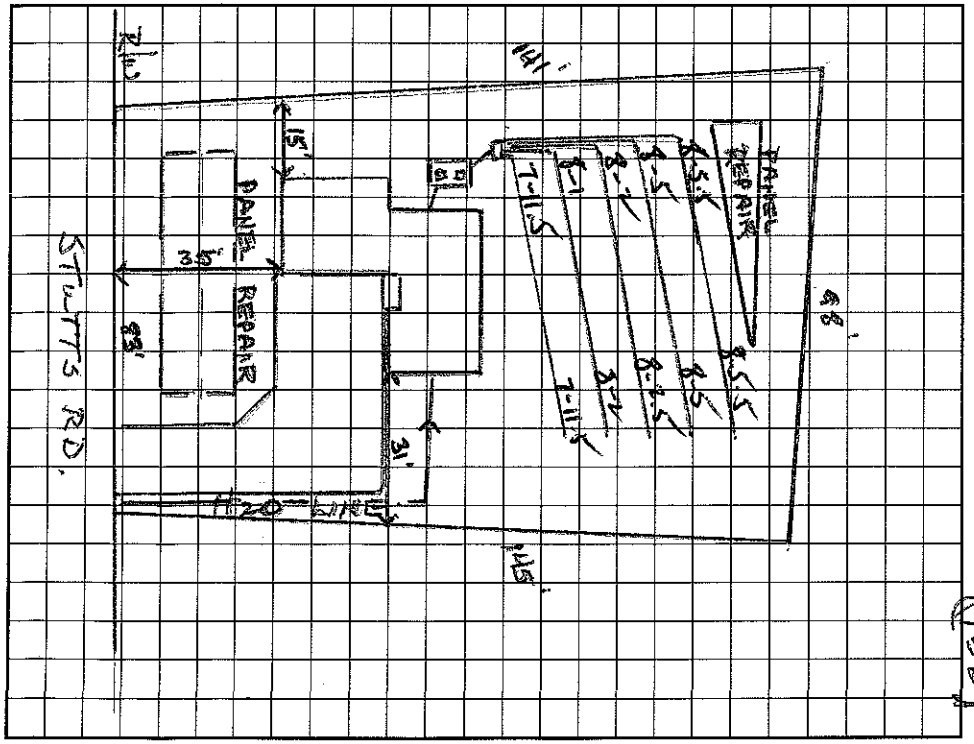

AS BUILT SKETCH

I understand that this permit can be suspended or revoked if any false information is supplied toward securing the permit/any unauthorized changes are made to the site/any unauthorized changes are made in the installation of the system. Improvement Permit with plat valid without expiration. Improvement Permit with site plan valid for sixty months. Authorization to Construct is valid for a period equal to that of Improvement Permit – not to exceed sixty months.

Signed: * Duane Lewis date 12-23-98 Installed by: MacLeod Const Co.

Improvement Permit by: date Operation Permit by: Wesley Sparks RS. date 7/29/99

Authorization to Construct by: Wesley Sparks RS. date 12/22/98 Existing System Inspection by: date

HEALTH DEPT. COPY: WHITE INSPECTION COPY (FINAL): GREEN OWNER COPY (FINAL): YELLOW INSPECTION COPY (INITIAL): PINK OWNER COPY (INITIAL): GOLD