IREDELL COUNTY HEALTH DEPARTMENT

Statesville Phone TR 3-7271 Mooresville Phone No. 664-5281

PERMIT TO INSTALL SEPTIC TANK

Permit No. 243 Permit Date 9-26-1973

Owner Hoyte Tyler Address Mooresville

Installed By F. J. Ervin Address Mooresville


Location of Property 1100 TL on 1112 to Coveview Park Lot no. 16

Tank		Capacity		Length of Lines		Fixtures	
Block	( )	1000	(✓)	225'	( )	No. of Baths	(2)
Precast	(✓)	1250	( )	250'	( )	Dishwasher	(yes)
		1500	( )	Other 240'		Garbage Grdr.	(no)
		Other				Other Washing machine	

NOTIFY HEALTH DEPARTMENT AT LEAST EIGHT HOURS BEFORE TANK IS TO BE INSPECTED.

Final Inspection 9-26-1973 Approved (✓) Disapproved ( )

Remarks Community Water System

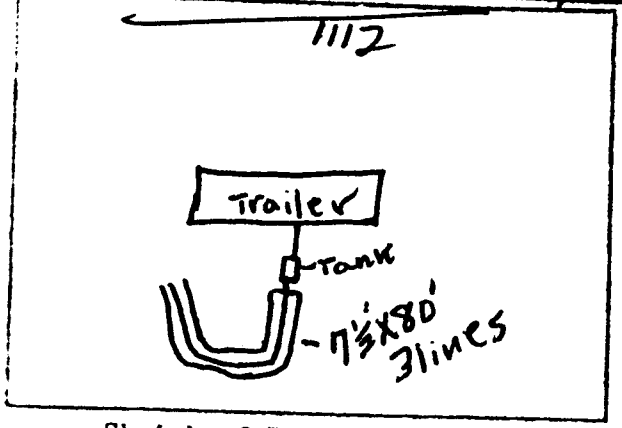

Sketch of Installation

J. C. Moore

Sanitarian