IREDELL COUNTY HEALTH DEPARTMENT

STATESVILLE 704-878-5305 3150 Paid MOORESVILLE 704-664-5281

IMPROVEMENT PERMIT / AUTHORIZATION TO CONSTRUCT / OPERATION PERMIT / EXISTING SYSTEM INSPECTION

PERMIT# 26160 PIN# 4636520745 DATE 2-21-05

OWNER OR CONTRACTOR Classic Carolina Homes LLC PHONE: Business 660-0709 Home

ADDRESS 2870 Charlotte Hwy Mooresville, NC 28117

LOCATION Brawley School Rd TL Stutts TR Poinsette TL Palmetto

SUBDIVISION Stutts Cove BLOCK / SECTION 2 LOT 18 LOT AREA .70 Acre SITE CLASS. RS DESIGN FLOW 480gpd L.T.A.R. .3

Septic Tank: 1000 Gallons; STB 525 Date

Pump Tank: 1000 Gallons; PT 302 Date 2/05/05

Pump Make: Zoeller Model N98-8 Serial No.

Nitrification Field: No Fields 1 Square Feet 540' Linear Feet 270'

No Lines 3 Trench Width 24" Max Trench Bottom Depth 36" Gravel Depth N/A

☒ New System ☐ Repair System Type: I, II, III, IV, V, VI

System Description: Pump-LP Panel Block

Repair System Description: Same

Maintenance Agreement Required: ☒ Yes ☐ No

☒ House/Mod. Home ☐ Mobile Home ☐ Business ☐ Other

No. Bedrooms 4 No. Bathrooms 4 No. Employees


☐ Slab ☐ Crawl Space ☒ Basement w/plumbing ☐ Basement wo/plumbing

Water Supply: ☒ Individual ☐ Public ☐ Community

Comments:/Conditions: Keep Septic System at least 50' from any well & 25' from basement wall.

Comments:/Conditions: 62 Panels 3/16" holes

INITIAL SITE SKETCH Scale 1:50

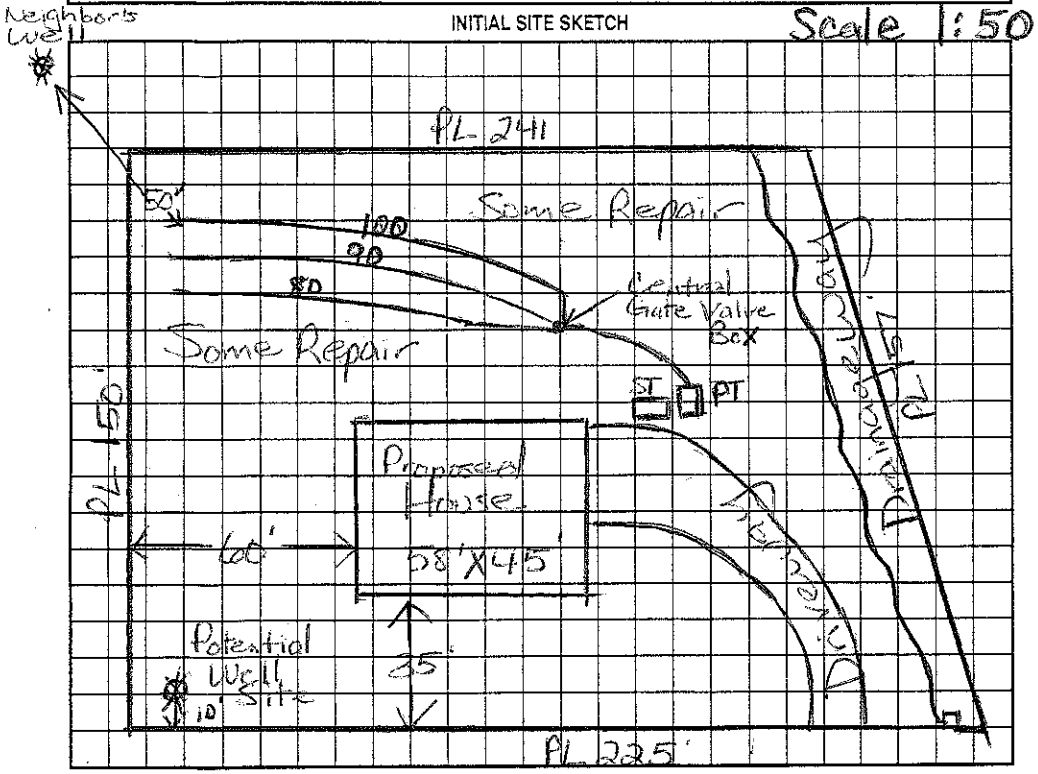

AS BUILT SKETCH

Permit can be suspended or revoked if any false information is supplied toward securing the permit/any unauthorized changes are made to the site/any unauthorized changes are made in the installation of the system. Improvement Permit with plan valid without expiration. Improvement Permit with site plan valid for sixty months. Authorization to Construct is valid for a period equal to that of Improvement Permit – not to exceed sixty months.

Signed: date 2/22/05 Installed by: Darrel Dobson

Improvement Permit by: Myra Hill Dobson RS date 2/21/05 Operation Permit by: date 6/2/05

Authorization to Construct by: Myra Hill Dobson RS date 2/21/05 Existing System Inspection by: date

HEALTH DEPT. COPY: WHITE OWNER COPY (FINAL): YELLOW OWNER COPY (INITIAL): PINK