Sammy 704 902-6878 4:00

IREDELL COUNTY HEALTH DEPARTMENT

STATESVILLE 704-878-5305 MOORESVILLE 704-664-5281

IMPROVEMENT PERMIT / AUTHORIZATION TO CONSTRUCT / OPERATION PERMIT / EXISTING SYSTEM INSPECTION

PERMIT# 114704 PIN# 4636521501

OWNER OR CONTRACTOR Julie & Aaron Berthelsen PHONE: Business 336 399-6613 Aaron Home 799-7599/799-5348 DATE 8-8-03

ADDRESS 175 Carriage Club Dr. #8-108 Mooresville, NC 28117

LOCATION Brawley School Rd TL Stutts TR Pionsetta TL Palmetto on right at end #124

SUBDIVISION Stutts Cove BLOCK / SECTION LOT 17 LOT AREA .80 Acre SITE CLASS PS DESIGN FLOW 480gpd L.T.A.R. .3

Septic Tank: 1000 Gallons; STB 1007 Date 11-12-03

Pump Tank: Gallons; PT Date

Pump Make: Model Serial No.

Nitrification Field: No Fields 1 Square Feet 1200 Linear Feet 400

No Lines 4@100' Trench Width 36" Max Trench Bottom Depth 26"-36" Gravel Depth N/A

☒ New System ☐ Repair System Type: I, II, (III), IV, V, VI

System Description: Gravity - 25% Reduction

Repair System Description: Pump/Grav - Innovative

Maintenance Agreement Required: ☐ Yes ☒ No

☒ House/Mod. Home ☐ Mobile Home ☐ Business ☐ Other


No. Bedrooms 4 No. Bathrooms 2.5 No. Employees

☐ Slab ☐ Crawl Space ☑ Basement w/plumbing ☐ Basement wo/plumbing

Water Supply: ☒ Individual ☐ Public ☐ Community


Comments/Conditions: Keep Septic System at least 10' from PL 100' from well & at least 15' from Cut 2ft of greater. Basement to have inflow grinder pump - Dkt for M.D.

INITIAL SITE SKETCH Scale 1:50'

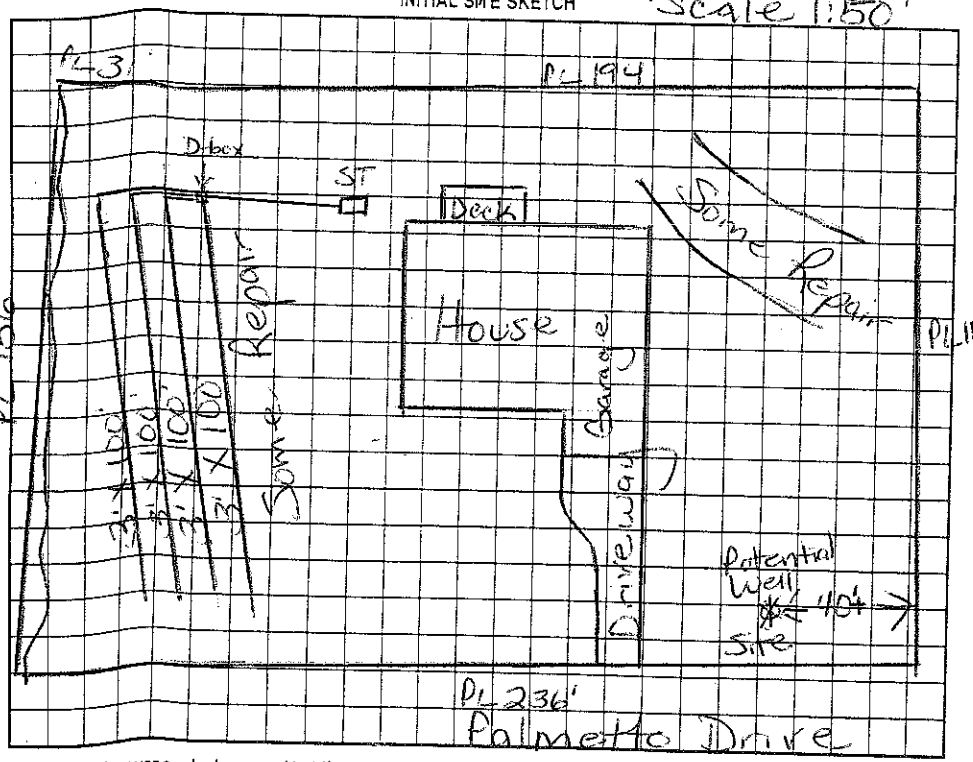

Comments/Conditions: Keep Septic System at least 15' from cut 2' or greater. 25' btw basement wall & Septic System. *Redraw of previously issued permit

AS BUILT SKETCH

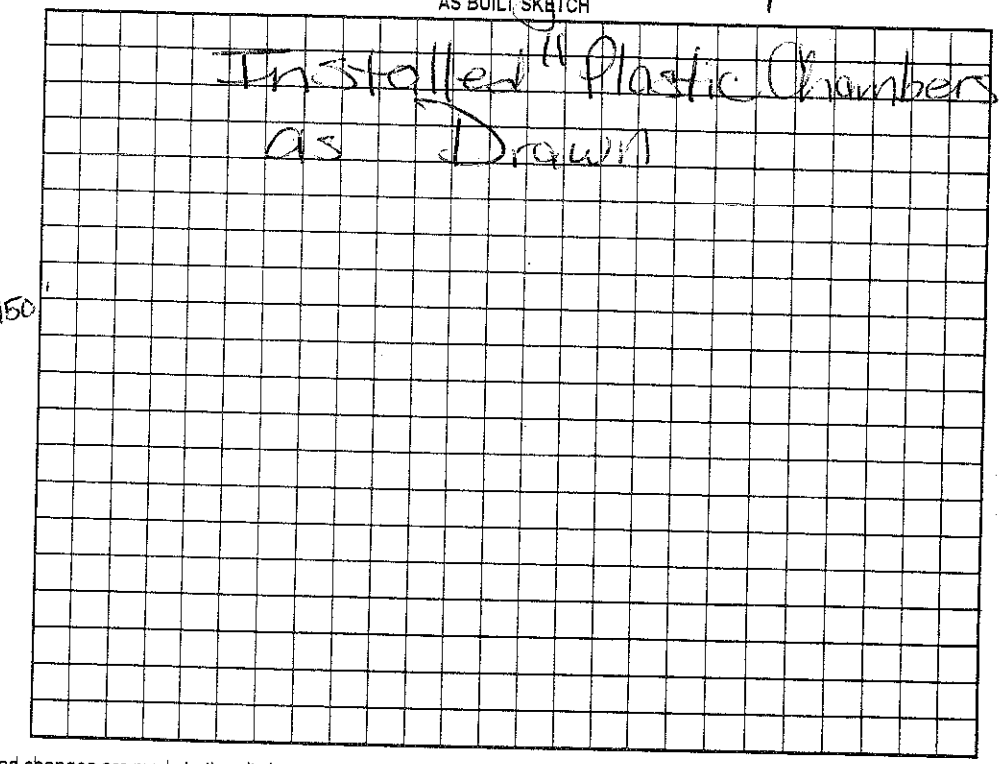

Permit can be suspended or revoked if any false information is supplied toward securing the permit/any unauthorized changes are made to the site/any unauthorized changes are made in the installation of the system. Improvement Permit with plat valid without expiration. Improvement Permit with site plan valid for sixty months. Authorization to Construct is valid for a period equal to that of Improvement Permit – not to exceed sixty months.

Signed: date 8/11/03

Improvement Permit by: Maria H. Dolson RS date 8/11/03

Authorization to Construct by: Maria H. Dolson RS date 8/11/03

Installed by: Tredell Brakhoe

Operation Permit by: Maria H. Dolson date 2/23/04

Existing System Inspection by: date

HEALTH DEPT. COPY: WHITE OWNER COPY (FINAL): YELLOW OWNER COPY (INITIAL): PINK