# IREDELL COUNTY HEALTH DEPARTMENT

STATESVILLE 704-878-5305 MOORESVILLE 704-664-5281

## IMPROVEMENT PERMIT / AUTHORIZATION TO CONSTRUCT / OPERATION PERMIT / EXISTING SYSTEM INSPECTION

PERMIT # 154347 PIN # 4636522773 DATE 1/7/09

OWNER or APPLICANT Jerry Rende PHONE: Business 704-890-4921 Home: Same

OWNER or APPLICANT ADDRESS 20208 Floral Ln Cornelius, NC 28031

LOCATION / DIRECTIONS Brawley School Rd., TL Stutts, TR Poinsetta, TL Palmetto, on lft.

SUBDIVISION Stutts Cove BLOCK / SECTION LOT # 11 LOT AREA 0.72 DESIGN FLOW 360 L.T.A.R. 0.3

Septic Tank 1000 Gallons: STB 760 Date 7-23-01

Pump Tank Gallons: PT Date

Pump Make Model Serial #

Nitrification Field No Fields 1 No Lines 5 Linear Feet 400

Trench Width 36" Max. Trench Bottom Depth 36" Gravel Depth 12" ☑ GRAVITY ☐ PRESSURE

☐ New System ☐ Repair ☐ Expansion System Type I II III IV V VI

System Description: Existing gravity, conventional

Repair System Description: gravity innovative

Maintenance Agreement Required ☐ YES ☒ NO

☑ Residence No. Bedrooms 3

☐ Business No. Persons

☐ Other No. Employees

☐ Slab ☑ Crawl Space


☐ Basement w/plumbing ☐ Basement w/o plumbing

Water Supply: ☑ Private ☐ Public ☐ Community


Comments / Conditions: New building must be 25' from well

Comments / Conditions

INITIAL SITE SKETCH

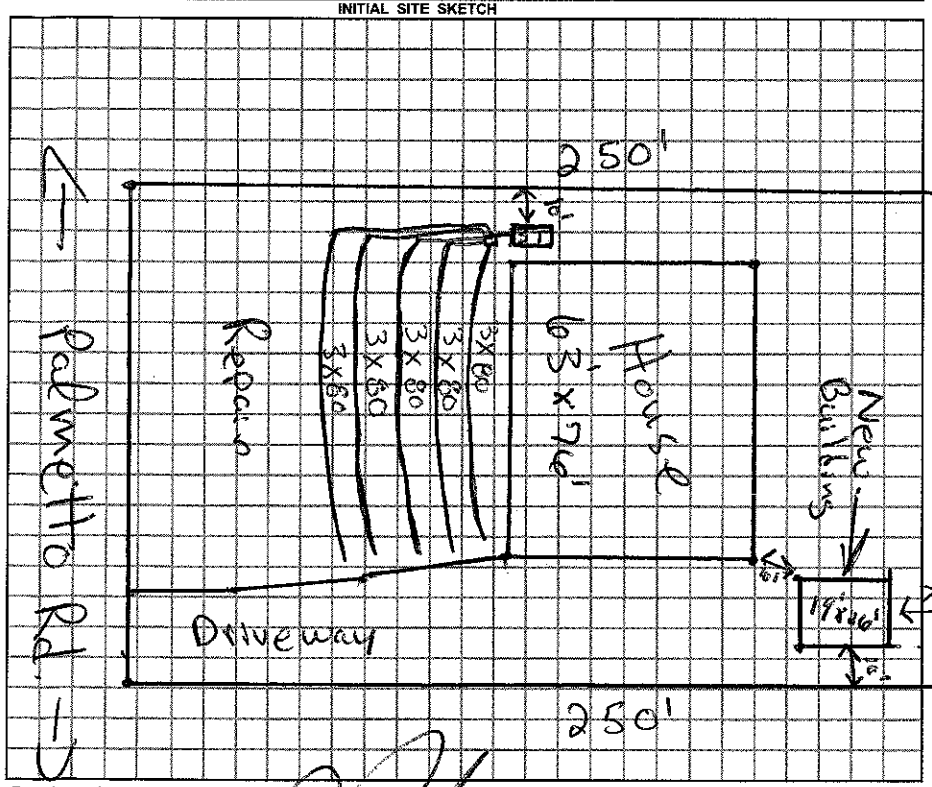


AS BUILT SKETCH

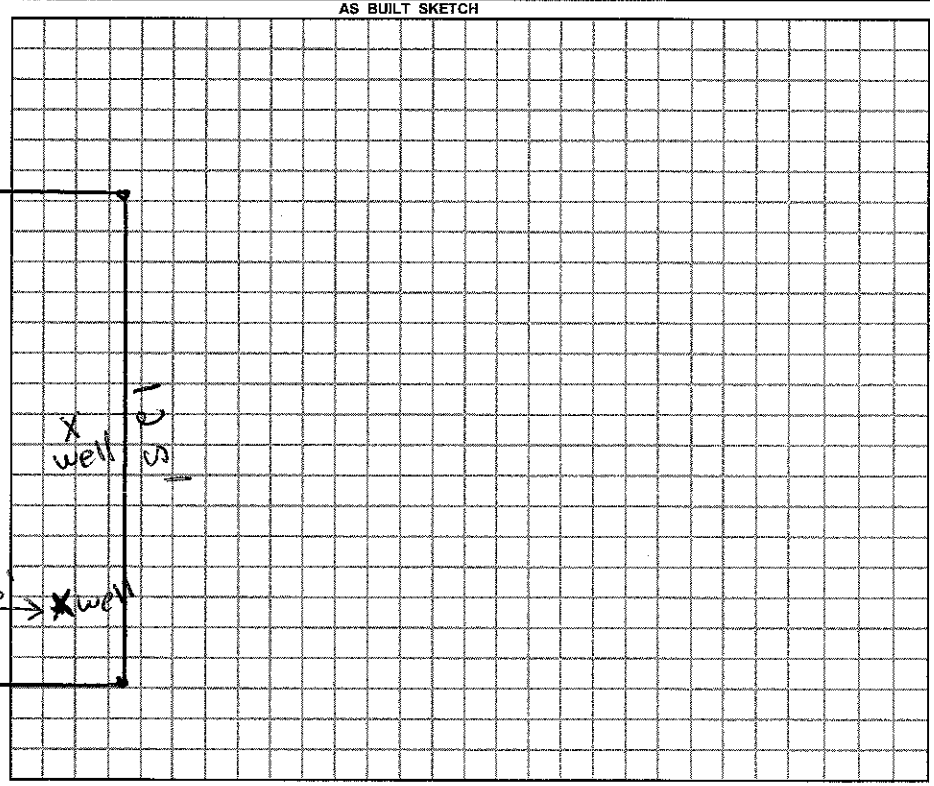


*Permit can be suspended or revoked if any false information is supplied toward securing the permit / any unauthorized changes are made to the site / any unauthorized changes are made in the installation of the system.*

☐ *IMPROVEMENT PERMIT w / plat valid without expiration.* ☐ *IMPROVEMENT PERMIT w / site plan valid for 60 mos.* ☐ *AUTHORIZATION TO CONSTRUCT valid for period equal to IMPROVEMENT PERMIT-not to exceed 60 mo.*

Owner / Applicant Signature: Date 1/8/09

Improvement Permit by: Date

Authorization to Construct by: Date

***YOU SHOULD CONTACT A LOCATOR SERVICE PRIOR TO ANY EXCAVATION.***

Installed by:

Operation Permit by: Date:

Existing System Inspected by: Date: 1/7/09

WHITE COPY Environmental Health YELLOW COPY (Final) Owner / Applicant PINK COPY (Initial) Owner / Applicant