# IREDELL COUNTY HEALTH DEPARTMENT

STATESVILLE 704-878-5305 50.00 Paid MOORESVILLE 704-664-5281 4.15

## IMPROVEMENT PERMIT / AUTHORIZATION TO CONSTRUCT / OPERATION PERMIT / EXISTING SYSTEM INSPECTION

PERMIT# 075377 PIN# 4636307807PT DATE 7/26/200

OWNER OR CONTRACTOR Mark Howard PHONE: Business _____ Home (704) 791-1646

ADDRESS P.O. Box 3533, Mooresville, NC 28117

LOCATION Brawley School Rd TL Stutts Rd TR into Stutts Cove (Poinsetta) TL 1st street (L

SUBDIVISION Stutts Cove BLOCK / SECTION _____ LOT 11 LOT AREA _____ SITE CLASS. PS DESIGN FLOW 360gpd L.T.A.R. .3

Septic Tank: 1000 Gallons: STB 760 Date 7-23-01
Pump Tank: _____ Gallons: PT _____ Date _____
Pump Make: _____ Model _____ Serial No. _____
Nitrification Field: No Fields 1 Square Feet 1200' Linear Feet 400'
No Lines 5@80' Trench Width 36" Max Trench Bottom Depth 36" Gravel Depth 12"

X New System ☐ Repair System Type: I II III IV V VI
System Description: Gravity - Conventional
Repair System Description: Gravity - Innovative
Maintenance Agreement Required: ☐ Yes X No
☐ Slab X Crawl Space ☐ Basement w/plumbing ☐ Basement wo/plumbing


X House/Mod. Home No. Bedrooms 3+
☐ Mobile Home No. Bathrooms 2.5
☐ Business No. Employees _____
☐ Other _____

Water Supply: X Individual ☐ Public ☐ Community

Comments:/Conditions: Keep Septic System at least 10' from, 50' from any well & at least 5' from Foundation.

Comments:/Conditions: Okay to use "Drop boxes" instead of Dist. box. Checked lines 1, 2 & 3 & tanks 9/28/2001

INITIAL SITE SKETCH Scale 1:50'

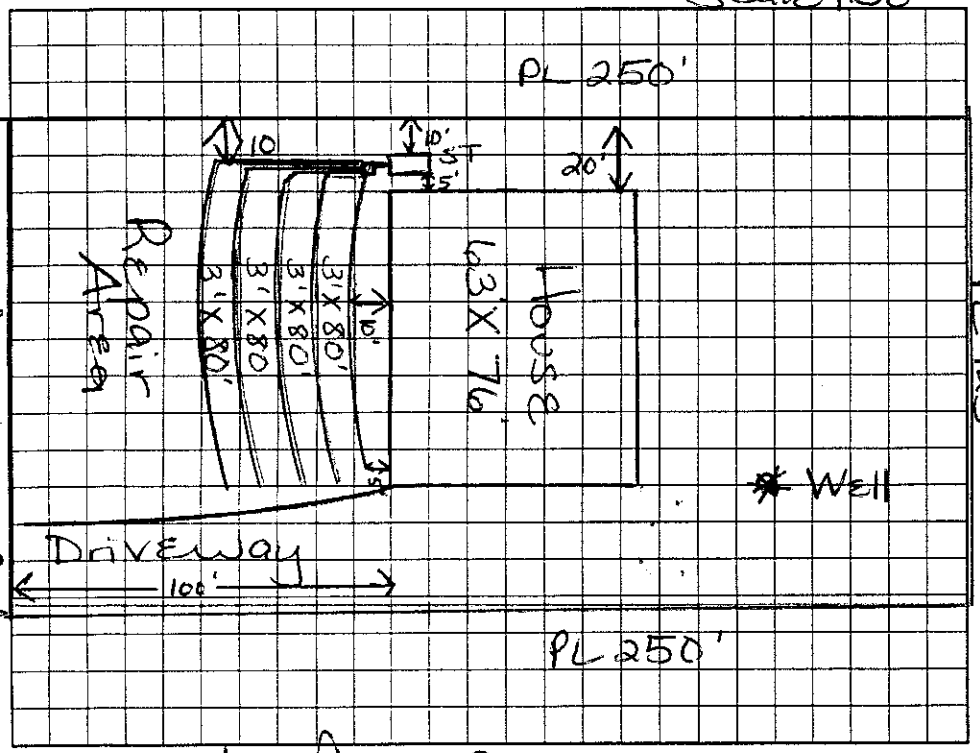


AS BUILT SKETCH

Installed Conv. lines

Permit can be suspended or revoked if any false information is supplied toward securing the permit/any unauthorized changes are made to the site/any unauthorized changes are made in the installation of the system. Improvemer
Permit with plat valid without expiration. Improvement Permit with site plan valid for sixty months. Authorization to Construct is valid for a period equal to that of Improvement Permit – not to exceed sixty months.

Signed: Mark Howard date 08/03/01 Installed by: Randy Miller

Improvement Permit by: Maria H. Dotson RS date 7/26/01 Operation Permit by: [signature] RS date 10/1/01

Authorization to Construct by: Maria H. Dotson RS date 7/26/01 Existing System Inspection by: _____ date _____