IREDELL COUNTY HEALTH DEPARTMENT

Statesville Phone TR 3-7271 . Mooresville Phone No. 664-5281

PERMIT TO INSTALL SEPTIC TANK

Permit No. 165 Permit Date 7-6- 1973

Owner Jack Sanders Address Charlotte

Installed By Leatherman Address Lincoln Co.

Location of Property 1100 ~~ft~~ TL on 1112


Go to Coveview Park Lot 7

Tank		Capacity		Length of Lines		Fixtures (max.)	
Block	( )	1000	(✓)	225'	(✓)	No. of Baths	(2)
Precast	(✓)	1250	( )	250'	( )	Dishwasher	(no)
		1500	( )	Other		Garbage Grdr.	(no)
		Other				Other washing machine	

NOTIFY HEALTH DEPARTMENT AT LEAST EIGHT HOURS BEFORE TANK IS TO BE INSPECTED.

Final Inspection 7-6- 1973 Approved (✓) Disapproved ( )

Remarks Community water system

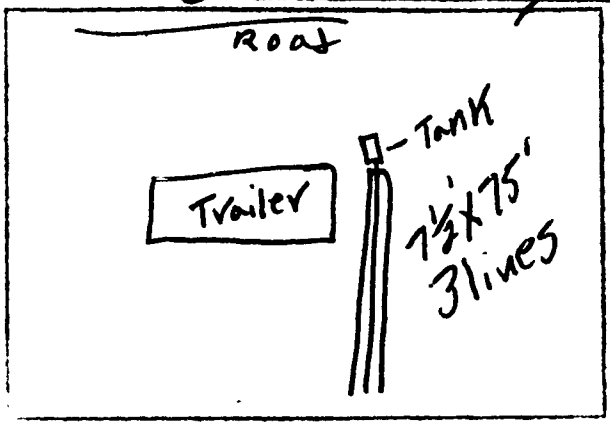

Sketch of Installation

J. C. Moore

Sanitarian