IREDELL COUNTY HEALTH DEPARTMENT

STATESVILLE 704-878-5305 130.00 Paid MOORESVILLE 704-664-5281 11.00

IMPROVEMENT PERMIT / AUTHORIZATION TO CONSTRUCT / OPERATION PERMIT / EXISTING SYSTEM INSPECTI

PERMIT# 12553370 PIN# 4636523397 DATE 12-9-04

OWNER OR CONTRACTOR Eric Broach PHONE: Business 634-4339 Home

ADDRESS 1071 Emerson Drive Mooresville NC 28115 #133

LOCATION Brawley School Rd TL Stutts Rd TR Poinsettia TL Palmetto Dr on left

SUBDIVISION Stutts Cove BLOCK / SECTION 7 LOT 14 LOT AREA .82 Acre SITE CLASS PS DESIGN FLOW 480gpd T.A.R. .3

Septic Tank: 1000 Gallons; STB 312 Date 4-25-05
Pump Tank: 1000 Gallons; PT 283 Date 5-29-05
Pump Make: Goulds Model WE05111H Serial No. S04645862
Nitrification Field: No Fields 1 Square Feet 1215 Linear Feet 405
No Lines 3@135 Trench Width 36" Max Trench Bottom Depth 36" Gravel Depth N/A

☒ New System ☐ Repair System Type: I, II, III, IV, V, VI
System Description: Pump-PM-25% Reduction
Repair System Description: Pump-LP-Panel Blk
Maintenance Agreement Required: ☐ Yes ☒ No Not Initially

☒ House/Mod. Home ☐ Mobile Home ☐ Business ☐ Other
No. Bedrooms 4 No. Bathrooms 3.5 No. Employees
☐ Slab ☒ Crawl Space ☐ Basement w/plumbing ☐ Basement wo/plumbing


Water Supply: ☒ Individual ☐ Public ☐ Community

Comments:/Conditions: Keep Septic System at least 10' From PL & 100' to well

Comments:/Conditions: Checked lines & tanks 7/5/05 Pressure electric alarm 8/19/05

Scale 1"=50'

INITIAL SITE SKETCH

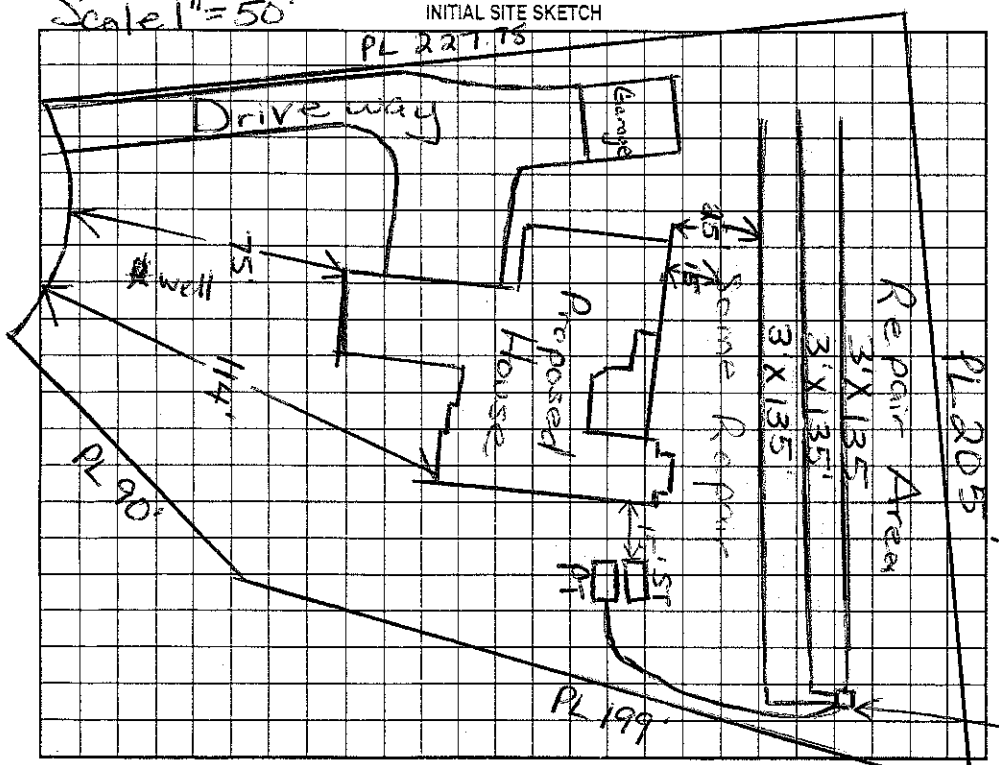

AS BUILT SKETCH

Installed "Plastic Chambers" as Drawn (Standard Infiltrator)

Pressure Manifold (PM)

Permit can be suspended or revoked if any false information is supplied toward securing the permit/any unauthorized changes are made to the site/any unauthorized changes are made in the installation of the system. Improvement Permit with plat valid without expiration. Improvement Permit with site plan valid for sixty months. Authorization to Construct is valid for a period equal to that of Improvement Permit – not to exceed sixty months.

Signed: Eric Broach date 12/10/04 Installed by: F.J. Evans RS date 8/19/05

Improvement Permit by: Marvin H. Dotson RS date 12/9/04 Operation Permit by: Marvin H. Dotson date 8/19/05

Authorization to Construct by: Marvin H. Dotson RS date 12/9/04 Existing System Inspection by: date

HEALTH DEPT. COPY: WHITE OWNER COPY (FINAL): YELLOW OWNER COPY (INITIAL): PINK