IREDELL COUNTY HEALTH DEPARTMENT

STATESVILLE 704-878-5305 130,000 Eq. 8 MOORESVILLE 704-664-5281

IMPROVEMENT PERMIT / AUTHORIZATION TO CONSTRUCT / OPERATION PERMIT / EXISTING SYSTEM INSPECTION

PERMIT# 126159 PIN# 4636523449 Dennis Cameron DATE 2-21-05

OWNER OR CONTRACTOR Classic Carolina Homes LLC PHONE: Business 660-0709 Home

ADDRESS 2870 Charlotte Hwy Mooresville NC 28117

LOCATION Brawley School Rd TL Stutts Rd TR Poinsetta Ln TL Palmetto Drive, on left at end

SUBDIVISION Stutts Cove BLOCK / SECTION LOT 13 LOT AREA .71 Acre SITE CLASS. PS DESIGN FLOW 480gpd L.T.A.R. .3

Septic Tank: 1000 Gallons; STB-Sh Date 5-16-05 (Shape)

Pump Tank: 1000 Gallons; PT Date 10-4-06

Pump Make: Model Serial No.

Nitrification Field: No Fields 1 Square Feet 400' Linear Feet 400'

No Lines 4@100' Trench Width 36" Max Trench Bottom Depth 36"

☒ New System ☐ Repair System Type: I, II, III, IV, V, VI

System Description: Pump-HH-25% Reduction

Repair System Description: Pump LP Panel Blk

Maintenance Agreement Required: ☐ Yes ☐ No

Gravel Depth N/A ☐ Slab ☒ Crawl Space ☐ Basement w/plumbing ☐ Basement wo/plumbing

☒ House/Mod. Home No. Bedrooms 4

☐ Mobile Home No. Bathrooms 4

☐ Business No. Employees

☐ Other


Water Supply: ☒ Individual ☐ Public ☐ Community

Comments/Conditions: Do Not set house any more than 100' from road (including porches)

Comments/Conditions: Note: Backfill against House foundation instead of cutting down therefore, 15' between house & drainfield (including Repair area) Tanks checked 3/21/06

Scale 1:50

INITIAL SITE SKETCH

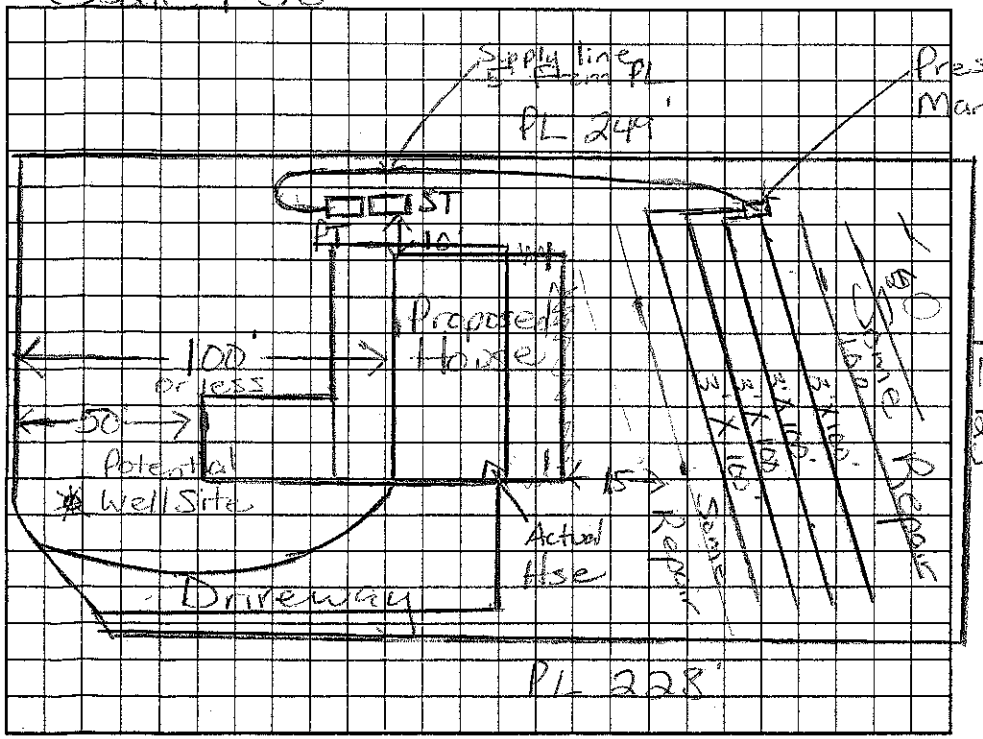

AS BUILT SKETCH

Permit can be suspended or revoked if any false information is supplied toward securing the permit/any unauthorized changes are made to the site/any unauthorized changes are made in the installation of the system. Improvement Permit with plat valid without expiration. Improvement Permit with site plan valid for sixty months. Authorization to Construct is valid for a period equal to that of Improvement Permit – not to exceed sixty months.

Signed: Dennis Cameron date 2/22/05 Installed by: Sonny Revis

Improvement Permit by: Maria H. Dotson RS date 2/21/05 Operation Permit by: Wesley Sparks RS date 5/26/06

Authorization to Construct by: Maria H. Dotson RS date 2/21/05 Existing System Inspection by: date

HEALTH DEPT. COPY: WHITE OWNER COPY (FINAL): YELLOW OWNER COPY (INITIAL): PINK