IREDELL COUNTY HEALTH DEPARTMENT

STATESVILLE 704-878-5305 50.00 Paid MOORESVILLE 704-664-5281

IMPROVEMENT PERMIT / AUTHORIZATION TO CONSTRUCT / OPERATION PERMIT / EXISTING SYSTEM INSPE ON

PERMIT# 07537 / 11685 PIN# ~~4636-30-7807~~ 4636525687 DATE 10/31/03

OWNER OR CONTRACTOR Campagna Homes Inc PHONE: Business 704-654-1185 Home

ADDRESS 308 Blume Rd Mooresville NC 28117

LOCATION BSR TL Stutts, on Rt

SUBDIVISION Stutts Cove BLOCK / SECTION LOT 5 LOT AREA 0.72Ac SITE CLASS PS DESIGN FLOW 440 L.T.A.R. 0.5

Septic Tank: 1000 Gallons; STB 825 Date 12-21-03
Pump Tank: 1000 Gallons; PT Date
Pump Make: Model Serial No.
Nitrification Field: No Fields 1 Square Feet 1200 Linear Feet 400
No Lines 4@100' Trench Width 36" Max Trench Bottom Depth 36" Gravel Depth —

☒ New System ☐ Repair System Type: I II III IV V VI Type II
System Description: ~~Gravity~~ 25% Reduction
Repair System Description: Gravity Panel Block
Maintenance Agreement Required: ☐ Yes ☒ No


☒ House/Mod. Home No. Bedrooms 4
☐ Mobile Home No. Bathrooms 2.5
☐ Business No. Employees
☐ Other
☐ Slab ☒ Crawl Space ☐ Basement w/plumbing ☐ Basement wo/plumbing

Water Supply: ☒ Individual ☐ Public ☐ Community


Comments:/Conditions:

Comments:/Conditions: Used Speed levelers & installed blue filter

INITIAL SITE SKETCH

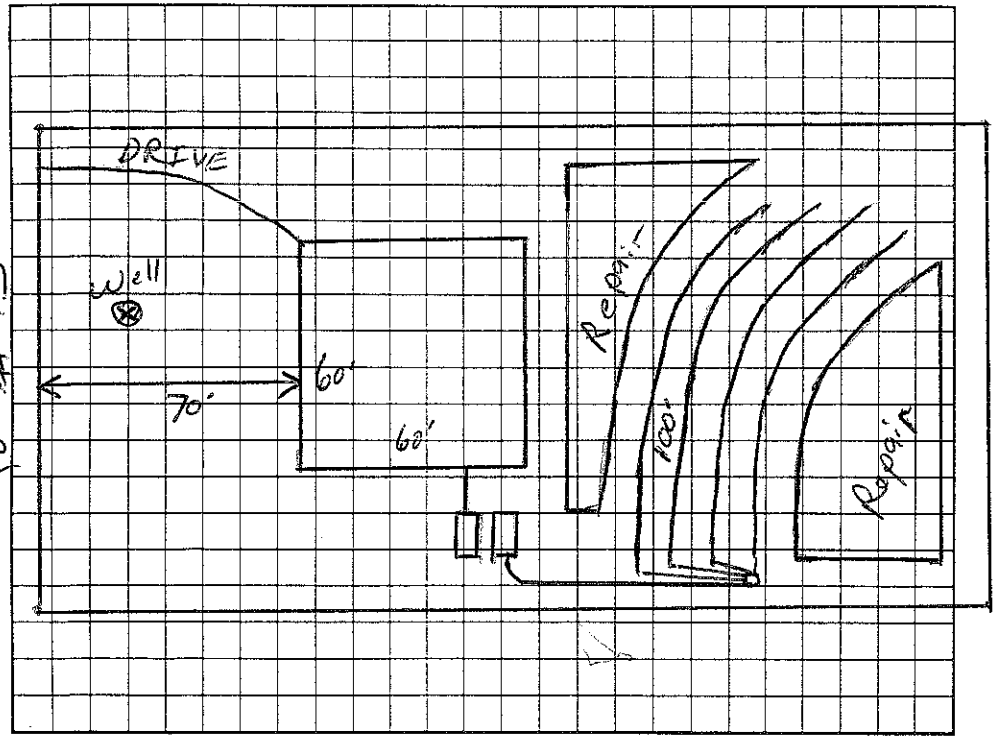

AS BUILT SKETCH

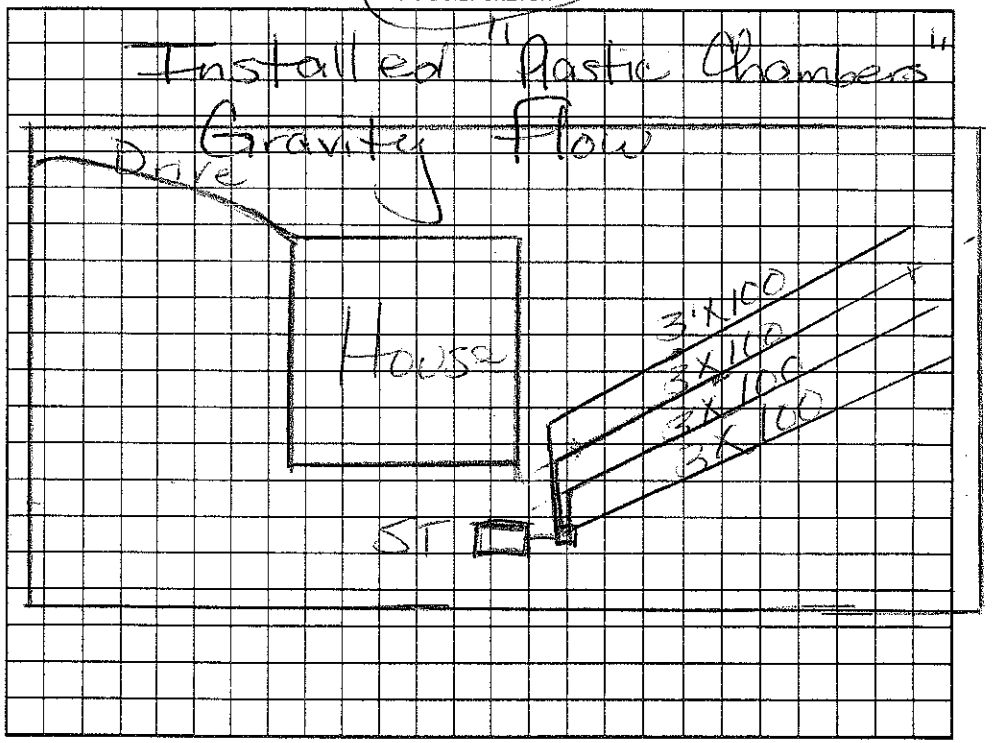

Permit can be suspended or revoked if any false information is supplied toward securing the permit/any unauthorized changes are made to the site/any unauthorized changes are made in the installation of the system. Improvement Permit with plat valid without expiration. Improvement Permit with site plan valid for sixty months. Authorization to Construct is valid for a period equal to that of Improvement Permit -- not to exceed sixty months.

Signed: Campagna date 11/10/03 Installed by: Rowan Septic RS

Improvement Permit by: RS date 10/31/03 Operation Permit by: date 3/8/04

Authorization to Construct by: RS date 10/31/03 Existing System Inspection by: date

HEALTH DEPT. COPY: WHITE OWNER COPY (FINAL): YELLOW OWNER COPY (INITIAL): PINK