(2.00)-

IREDELL COUNTY HEALTH DEPARTMENT

STATESVILLE 704-878-5305 MOORESVILLE 704-664-5281

IMPROVEMENT PERMIT / AUTHORIZATION TO CONSTRUCT / OPERATION PERMIT / EXISTING SYSTEM INSPECTION

PERMIT# 07536B PIN# 4636307807 (pt) 4636526380 DATE Oct. 6, '98

OWNER OR CONTRACTOR Michael Fox & Assoc. PHONE: Business 588-3763 Home

ADDRESS 8537 S. Tryon St. Charlotte

LOCATION Brawley Sch Rd. TL Stutts Rd on Right past jct w/ Turby Hill Rd

SUBDIVISION Stutts Cove BLOCK / SECTION LOT 2 LOT AREA .69ac SITE CLASS. 25 DESIGN FLOW 360gpd L.T.A.R. .3

Septic Tank: 1000 Gallons; STB 1012 Date 5-9-99

Pump Tank: 1000 Gallons; PT 17 Date 3-15-99

Pump Make: Model Serial No.

Nitrification Field: No. Fields 1 Square Feet 1200 Linear Feet 400

No Lines 4@100' Trench Width 36" Max Trench Bottom Depth 36"

☑ New System ☐ Repair System Type: I, II, (III) IV, V, VI

System Description: pumped pm - Conventional

Repair System Description: pm - 25% Reduction

Maintenance Agreement Required: ☐ Yes ☒ No

☑ House/Mod. Home No. Bedrooms 3

☐ Mobile Home No. Bathrooms 2

☐ Business No. Employees

☐ Other

Gravel Depth 12" ☐ Slab ☑ Crawl Space ☐ Basement w/plumbing ☐ Basement wo/plumbing


Water Supply: ☑ Individual ☐ Public ☐ Community

Comments:/Conditions:

Comments:/Conditions:

1"=50'

INITIAL SITE SKETCH

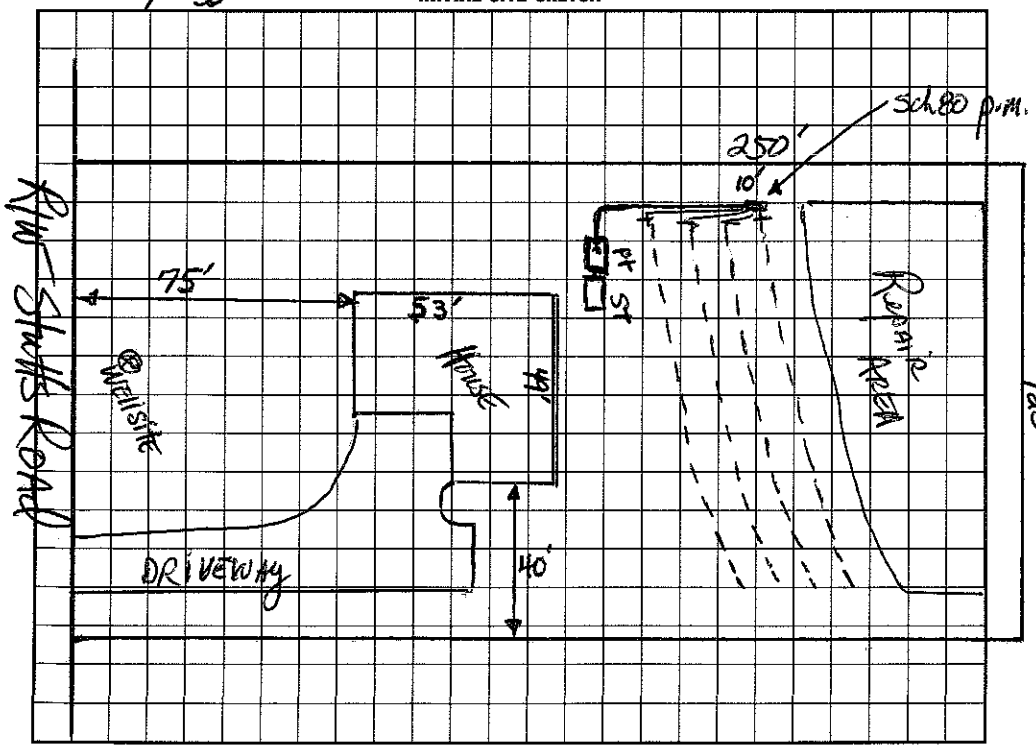

AS BUILT SKETCH

I understand that this permit can be suspended or revoked if any false information is supplied toward securing the permit/any unauthorized changes are made to the site/any unauthorized changes are made in the installation of the system. Improvement Permit with plat valid without expiration. Improvement Permit with site plan valid for sixty months. Authorization to Construct is valid for a period equal to that of Improvement Permit – not to exceed sixty months.

Signed: date 10-15-98

Improvement Permit by: RS date 10-6-98

Authorization to Construct by: RS date 10-6-98

Installed by: Richard A Dorsett

Operation Permit by: Maria Dotson RS date 8/23/99

Existing System Inspection by: date

HEALTH DEPT. COPY: WHITE INSPECTION COPY (FINAL): GREEN OWNER COPY (FINAL): YELLOW INSPECTION COPY (INITIAL): PINK OWNER COPY (INITIAL): GOLD