IREDELL COUNTY HEALTH DEPARTMENT

STATESVILLE 704-878-5305 50.00 Paid MOORESVILLE 704-664-5281

IMPROVEMENT PERMIT / AUTHORIZATION TO CONSTRUCT / OPERATION PERMIT / EXISTING SYSTEM INSPECTION

PERMIT# 075369 PIN# 4636 70 7807 Pt. 4636 52 6453 DATE 8/1/01

OWNER OR CONTRACTOR NuHouse Properties PHONE: Business 704-793-4700 Home

ADDRESS 11 Concord Commons Concord, NC. 28027

LOCATION 1100 Tr St Hs Rd. on (R) past Poinsettia Ln. 356 Stutts Rd

SUBDIVISION Stutts Cove BLOCK / SECTION 1 LOT 3 LOT AREA .69 Ac SITE CLASS. PS DESIGN FLOW 360 L.T.A.R. .3

Septic Tank: 1000 Gallons; STB 1600 Date 10-30-01
Pump Tank: 1000 Gallons; PT 319 Date 12/7/01
Pump Make: Little Giant Model 10SLH 1/2Hp Serial No.
Nitrification Field: No Fields 1 Square Feet 1200 Linear Feet 400
No Lines 4@100' Trench Width 3' Max Trench Bottom Depth 30" Gravel Depth 12"

☑ New System ☐ Repair System Type: I, II, (III), IV, V, VI
System Description: PM → Conventional
Repair System Description: PM → 25% Reduced
Maintenance Agreement Required: ☐ Yes ☒ No

☒ House/Mod. Home No. Bedrooms 3
☐ Mobile Home No. Bathrooms 2.5
☐ Business No. Employees
☐ Other
☐ Slab ☒ Crawl Space ☐ Basement w/plumbing ☐ Basement wo/plumbing


Water Supply: ☒ Individual ☐ Public ☐ Community

Comments:/Conditions: 10' from all PL's; 10' from house, 50' from all wells.

Comments:/Conditions:

(1" = 50')

INITIAL SITE SKETCH

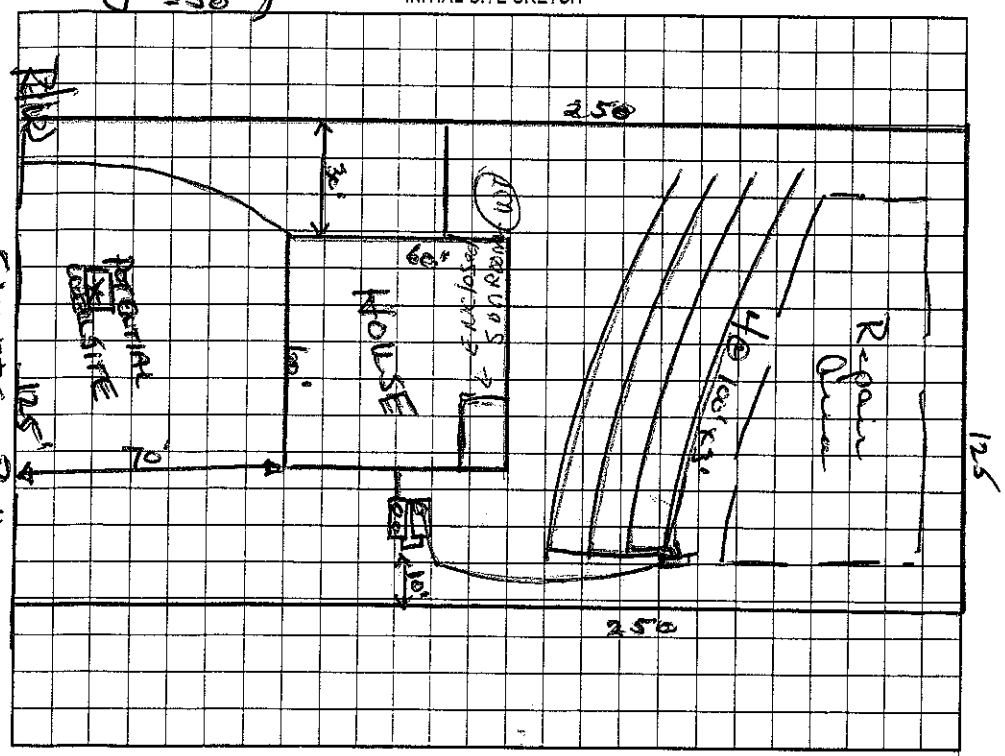

AS BUILT SKETCH

The proposed / existing Enclosed sun room addition does not appear to impact the existing septic system.
**NOTE: w/in existing footprint

Wesley Melville R.S.
Date: 1-20-10
ICHD-Environmental Health Division

Permit can be suspended or revoked if any false information is supplied toward securing the permit/any unauthorized changes are made to the site/any unauthorized changes are made in the installation of the system. Improvement Permit with plat valid without expiration. Improvement Permit with site plan valid for sixty months. Authorization to Construct is valid for a period equal to that of Improvement Permit – not to exceed sixty months.

Signed: [signature] date

Improvement Permit by: Wesley Sparks R.S. date 8/1/01

Authorization to Construct by: Wesley Sparks R.S. date 8/1/01

Installed by: Macleod

Operation Permit by: [signature] R.S. date 2/12/02

Existing System Inspection by: date

HEALTH DEPT. COPY: WHITE OWNER COPY (FINAL): YELLOW OWNER COPY (INITIAL): PINK