IREDELL COUNTY HEALTH DEPARTMENT

STATESVILLE 704-878-5305 MOORESVILLE 704-664-5281

IMPROVEMENT PERMIT / AUTHORIZATION TO CONSTRUCT / OPERATION PERMIT / EXISTING SYSTEM INSPECTION

PERMIT# 25643 PIN# 2617 A6 4636-52-8685 DATE 6/10/98

OWNER OR CONTRACTOR SHAWN OGDEN Ogden PHONE: Business Home 361-0033

ADDRESS STUTTS RD MOORESVILLE NC 28115

LOCATION BRAWLEY SCHOOL - TL STUTTS RD - 5TH LOT ON L PAST NORMAN WOODS

SUBDIVISION NORMAN WOODS BLOCK / SECTION LOT 6 LOT AREA 20,000 ft² SITE CLASS. RS DESIGN FLOW 360 GPD T.A.R. .3 GPD/FT²

Septic Tank: 1000 Gallons; STB 1012 Date 7/14/98

Pump Tank: Gallons; PT Date

Pump Make: Model Serial No.

Nitrification Field: No Fields 1 Square Feet 900 Linear Feet 300

No Lines 4 @ 75' Trench Width 36" Max Trench Bottom Depth 36" Gravel Depth N/A

☑ New System ☐ Repair System Type: I, II, (III), IV, V, VI

System Description: GRAVITY CHAMBERS OR ADS

Repair System Description: SAME

Maintenance Agreement Required: ☐ Yes ☑ No

☑ House/Mod. Home No. Bedrooms 4

☐ Mobile Home No. Bathrooms 3

☐ Business No. Employees

☐ Other


☐ Slab ☑ Crawl Space ☐ Basement w/plumbing ☐ Basement wo/plumbing

Water Supply: ☑ Individual ☐ Public ☐ Community

Comments:/Conditions:

Comments:/Conditions:

INITIAL SITE SKETCH 1" = 40'

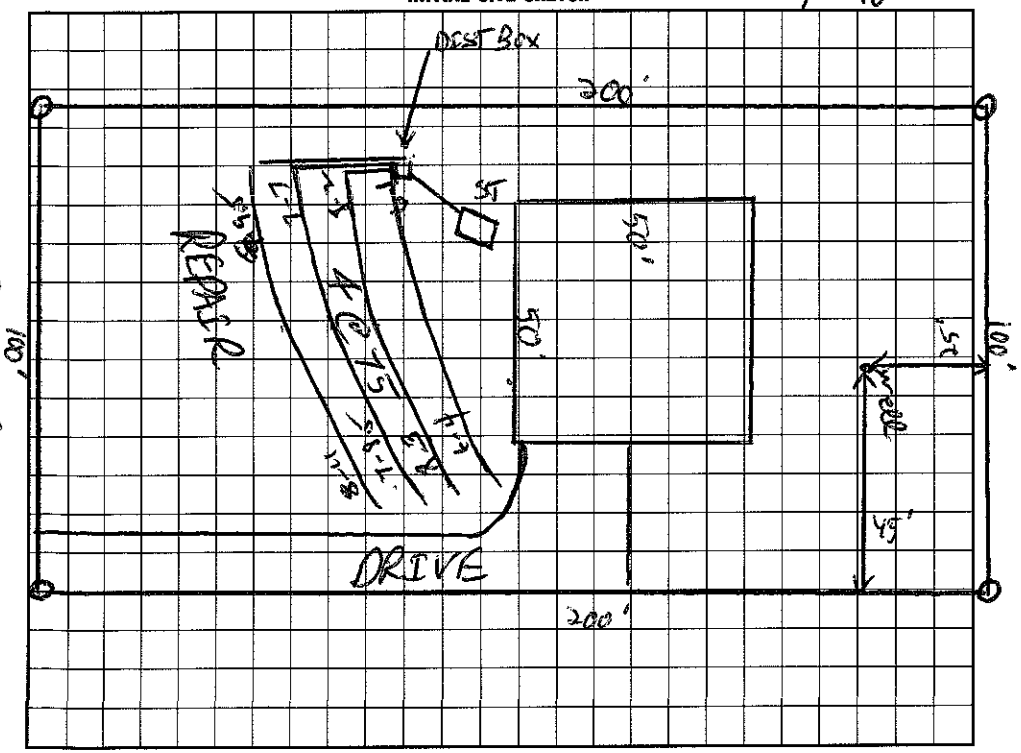

AS BUILT SKETCH

I understand that this permit can be suspended or revoked if any false information is supplied toward securing the permit/any unauthorized changes are made to the site/any unauthorized changes are made in the installation of the system. Improvement Permit with plat valid without expiration. Improvement Permit with site plan valid for sixty months. Authorization to Construct is valid for a period equal to that of Improvement Permit – not to exceed sixty months.

Signed: Shawn Ogden date 6-12-98 Installed by: Richard Abernathy

Improvement Permit by: C. Bentley Tarr RS date 6/10/98 Operation Permit by: Wesley Sparks RS date 9/16/98

Authorization to Construct by: C. Bentley Tarr RS date 6/10/98 Existing System Inspection by: date

HEALTH DEPT. COPY: WHITE INSPECTION COPY (FINAL): GREEN OWNER COPY (FINAL): YELLOW INSPECTION COPY (INITIAL): PINK OWNER COPY (INITIAL): GOLD