IREDELL COUNTY HEALTH DEPARTMENT

AUTHORIZATION TO CONSTRUCT

STATESVILLE 704-878-5305 MOORESVILLE 704-664-5281

IMPROVEMENT PERMIT / ~~CERTIFICATE OF COMPLETION~~ / OPERATION PERMIT / EXISTING SYSTEM INSPECTI

PROPERTY DESCRIPTION NO. 25346 DATE 8/14/97 TAX MAP NO. 26-17-A-7 Watershed: ☑ Yes ☐

OWNER OR CONTRACTOR SHAWN OGDEN ~~PHONE: Business~~ 4636-52-8784 Home 662-0021

ADDRESS PO BOX 1281 DAVIDSON NC 28036

LOCATION BRAWLEY SCHOOL - TL STUTTS RD - 5TH LOT ON LEFT PAST WOODSTREAM

SUBDIVISION NORMAN WOODS BLOCK / SECTION ____ LOT 7 LOT AREA ____ SITE CLASS. PS DESIGN FLOW 360 L.T.A.R. .3

Septic Tank: 1000 Gallons; STB 794 Date 5/9/97

Pump Tank: ____ Gallons; PT ____ Date ____

Pump Make: ____ Model ____ Serial No. ____

Nitrification Field: No Fields 1 Square Feet 402 Linear Feet 201

No Lines 3 @ 67' Trench Width 36" Max Trench Bottom Depth 36" Gravel Depth N/A

☑ New System ☐ Repair System Type: I, II, III, IV, V, VI

System Description: GRAVITY PANEL

Repair System Description: SAME

Maintenance Agreement Required: ☐ Yes ☑ No

☑ House/Mod. Home No. Bedrooms 3

☐ Mobile Home No. Bathrooms 2

☐ Business No. Employees ____

☐ Other ____


☐ Slab ☑ Crawl Space ☐ Basement w/plumbing ☐ Basement wo/plumbing

Water Supply: ☑ Individual ☐ Community ☐ Public


Comments:

Comments: UPPER 2 LINES CHECKED

INITIAL SITE SKETCH 1"=40'

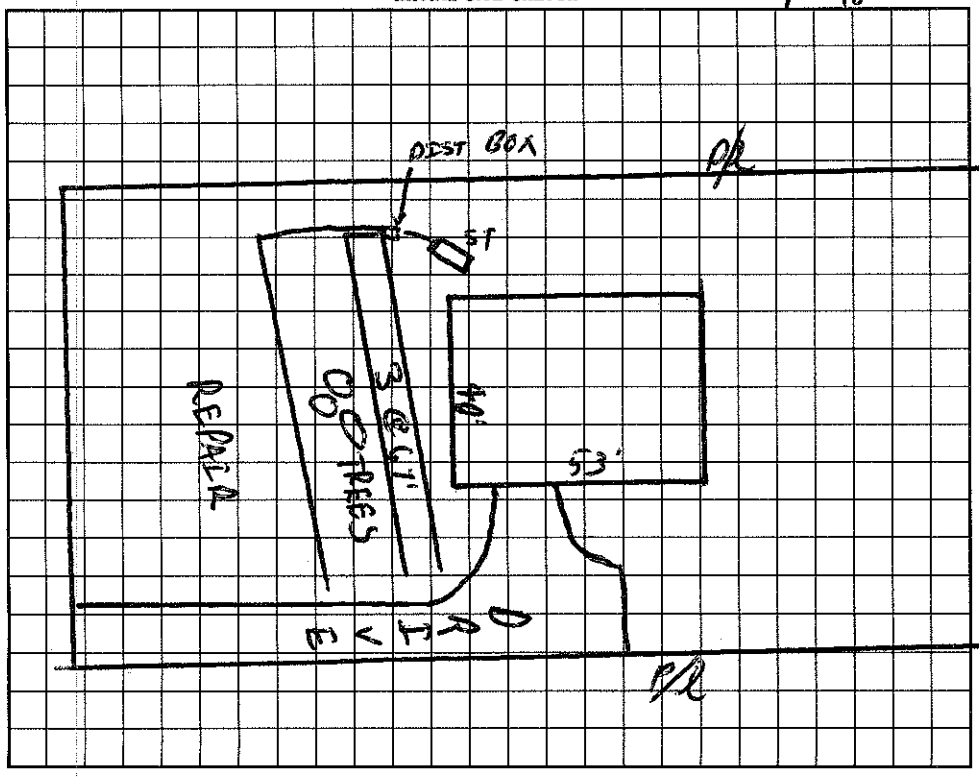

AS BUILT SKETCH

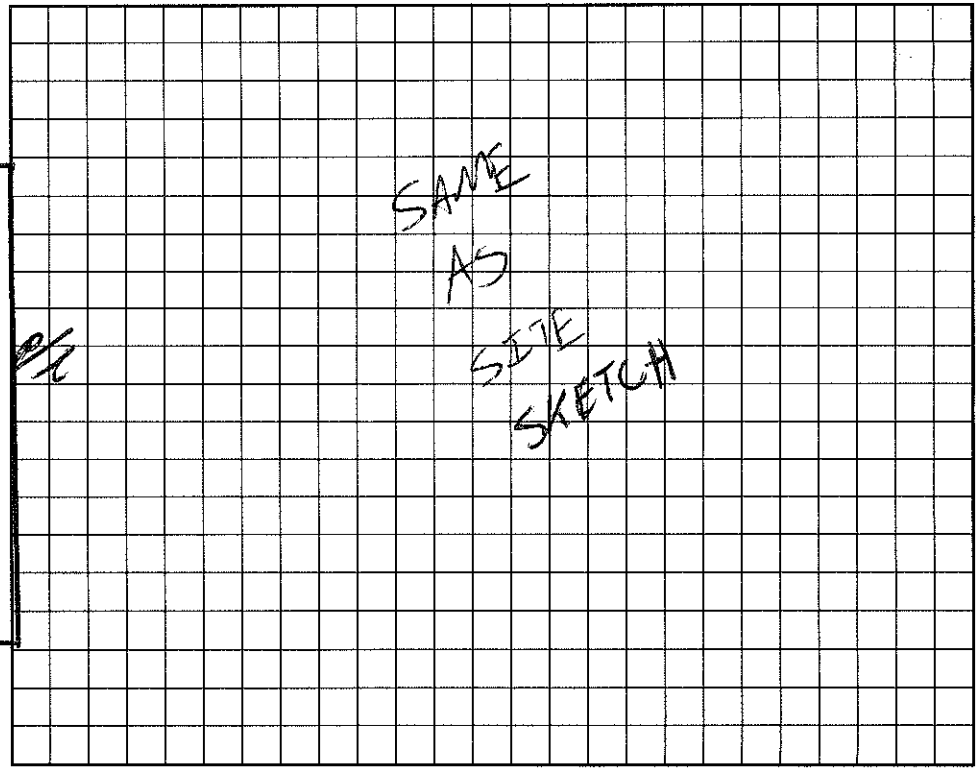

I understand that this permit can be suspended or revoked if any false information is supplied toward securing the permit/any unauthorized changes are made to the site/any unauthorized changes are made in the installation of the system. Improvement Permit is valid for 60 months from date of issuance.

Signed: Shawn Ogden

Improvement Permit by: C. [signature] date 8/14/97

AUTHORIZATION TO CONSTRUCT ~~Existing System Inspection by~~: C. [signature] date 8/14/97

Installed by: JAMES HUDLER

Certificate of Completion by: ____ date ____

Operation Permit by: C. [signature] date 8/25/97

HEALTH DEPT. COPY: WHITE INSPECTION COPY (FINAL): GREEN OWNER COPY (FINAL): YELLOW INSPECTION COPY (INITIAL): PINK OWNER COPY (INITIAL): GOLD