IREDELL COUNTY HEALTH DEPARTMENT

STATESVILLE 704-878-5305 MOORESVILLE 704-664-5281

IMPROVEMENT PERMIT / AUTHORIZATION TO CONSTRUCT / OPERATION PERMIT / EXISTING SYSTEM INSPECTION

PERMIT# 074518 PIN# 4636 52 9285 DATE 7/24/98

OWNER OR CONTRACTOR SAM MORAN PHONE: Business Home 588-3010

ADDRESS 8537 S TRYON ST CHARLOTTE NC 28273

LOCATION BRAWLEY SCHOOL - IL STUTTS - ON LEFT PAST WOODSTREAM

SUBDIVISION NORMAN WOODS BLOCK / SECTION LOT 0 LOT AREA SITE CLASS. RS DESIGN FLOW 360GPD L.T.A.R. .36 AC/FT

Septic Tank: 1000 Gallons; STB 1012 Date 7/12/98

Pump Tank: 1000 Gallons; PT 17 Date 7/17/98

Pump Make: MYERS Model MC-40M11 Serial No. 8/97

Nitrification Field: No Fields 1 Square Feet 900 Linear Feet 300

No Lines 4 @ 75' Trench Width 36" Max Trench Bottom Depth 36" Gravel Depth NA

☐ ~~New System~~ ☐ Repair System Type: I, II, III, IV, V, VI

System Description: PUMP CHAMBERS OR HDS

Repair System Description: PUMP PANEL

Maintenance Agreement Required: ☐ Yes ☑ No

☑ ~~House/Mod. Home~~ No. Bedrooms 3

☐ Mobile Home No. Bathrooms 2

☐ Business No. Employees

☐ Other

☐ Slab ☐ Crawl Space ☐ Basement w/plumbing ☐ Basement wo/plumbing


Water Supply: ☑ ~~Individual~~ ☐ Public ☐ Community

Comments:/Conditions:

Comments:/Conditions:

16" PPBS Repair Required

INITIAL SITE SKETCH

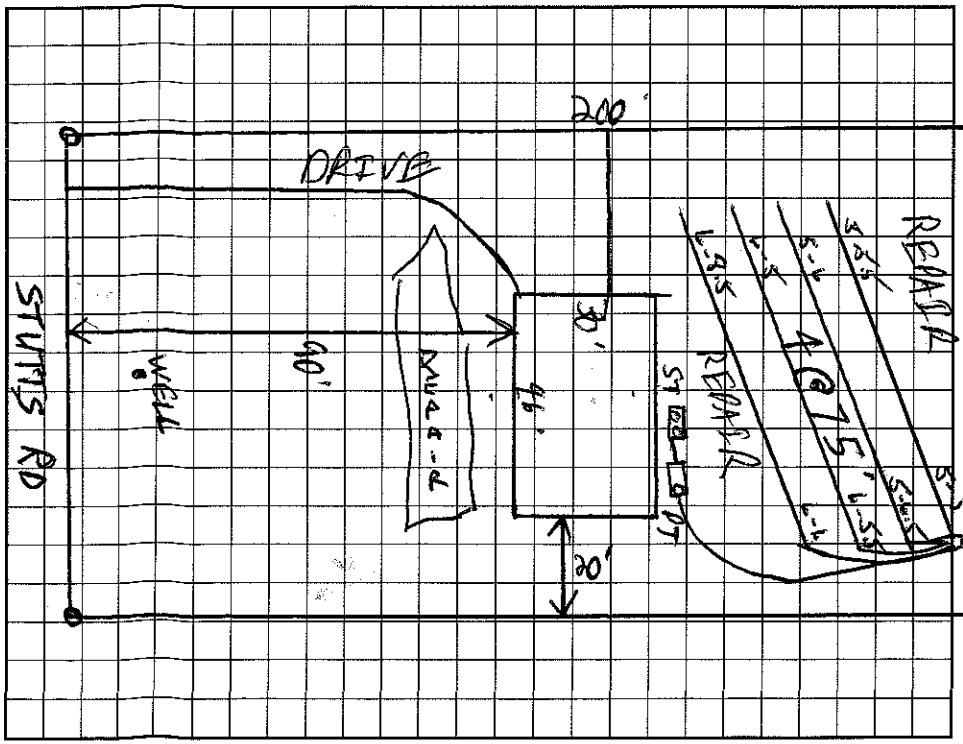

AS BUILT SKETCH

I understand that this permit can be suspended or revoked if any false information is supplied toward securing the permit/any unauthorized changes are made to the site/any unauthorized changes are made in the installation of the system. Improvement Permit with plat valid without expiration. Improvement Permit with site plan valid for sixty months. Authorization to Construct is valid for a period equal to that of Improvement Permit – not to exceed sixty months.

Signed: L. Shawn Ogden date

Improvement Permit by: [signature] RS date 7/24/98

Authorization to Construct by: [signature] RS date 7/24/98

Installed by: Richard Abernathy

Operation Permit by: [signature] RS date 2/17/99

Existing System Inspection by: date

HEALTH DEPT. COPY: WHITE INSPECTION COPY (FINAL): GREEN OWNER COPY (FINAL): YELLOW INSPECTION COPY (INITIAL): PINK OWNER COPY (INITIAL): GOLD