Expansion for Pool
Over 365.00 pd 8-20-08 SC

IREDELL COUNTY HEALTH DEPARTMENT

STATESVILLE 704-878-5305 MOORESVILLE 704-664-5281

IMPROVEMENT PERMIT / AUTHORIZATION TO CONSTRUCT / OPERATION PERMIT / EXISTING SYSTEM INSPECTION

PERMIT# 151956 PIN# 4636530200.000

OWNER OR APPLICANT David J & Emily H Wright DATE 8/19/08

ADDRESS 128 Poinsettia Ln. Mooresville NC PHONE: Business 704 662-4432 Home 704 660-7543

LOCATION Brawley School Rd. TR Stutts Rd. TR Poinsettia Ln. 128 Poinsettia

SUBDIVISION Stutts Cove BLOCK / SECTION 2 LOT 50 LOT AREA 1.8 acre SITE CLASS PS DESIGN FLOW 480 L.T.A.R. .3

Septic Tank Exis 1000 Gallons: STB ____ Date ____

Pump Tank: ____ Gallons: PT ____ Date ____

Pump Make: ____ Model ____ Serial No. ____

Nitrification Field: No. Fields 1 Square Feet 240' Linear Feet 80' (New) 5 total

No Line: (New) 5 total Trench Width 36" Max Trench Bottom Depth 36" Gravel Depth N/A

☑ New System ☐ Repair ☑ Expansion System Type: I II III IV V VI

System Description: 25% Reduction

Repair System Description: Pump 25% per LPP rec

Maintenance Agreement Required: ☐ Yes ☑ No

☑ Gravity ☐ Pressure

☑ House/Mod. Home ☐ Mobile Home ☐ Business ☐ Other Pool

No. Bedrooms 4 No. Persons ____ No. Employees ____

Water Supply: ☑ Individual Exis. ☐ Public ☐ Community


☐ Slab ☑ Crawl Space ☐ Basement w/plumbing ☐ Basement wo/plumbing

Comments:/Conditions: *Cut off 20' from each line (5 units) and fill back in. Install end caps. Keep 15' from cut of proposed pool. Add New 80' line connect to septic tank outlet, use End cap distribution. Install at 36" deep. 1 pass. Use 1 1/2 stone


Comments:/Conditions: (See permit 124663 Scott Ward-2005) Installed 80' line - 9/10/08 Quick 9/15 Finished abandoning lines within 5' of pool deep 1 pass. Use min separation

INITIAL SITE SKETCH

1" = 50' scale

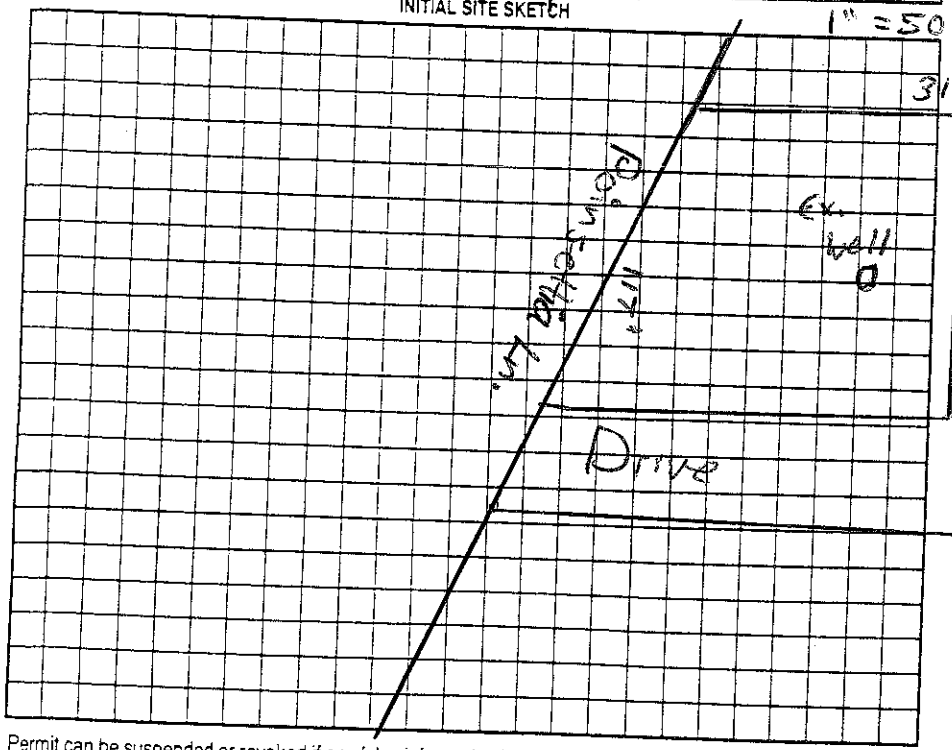

AS BUILT SKETCH

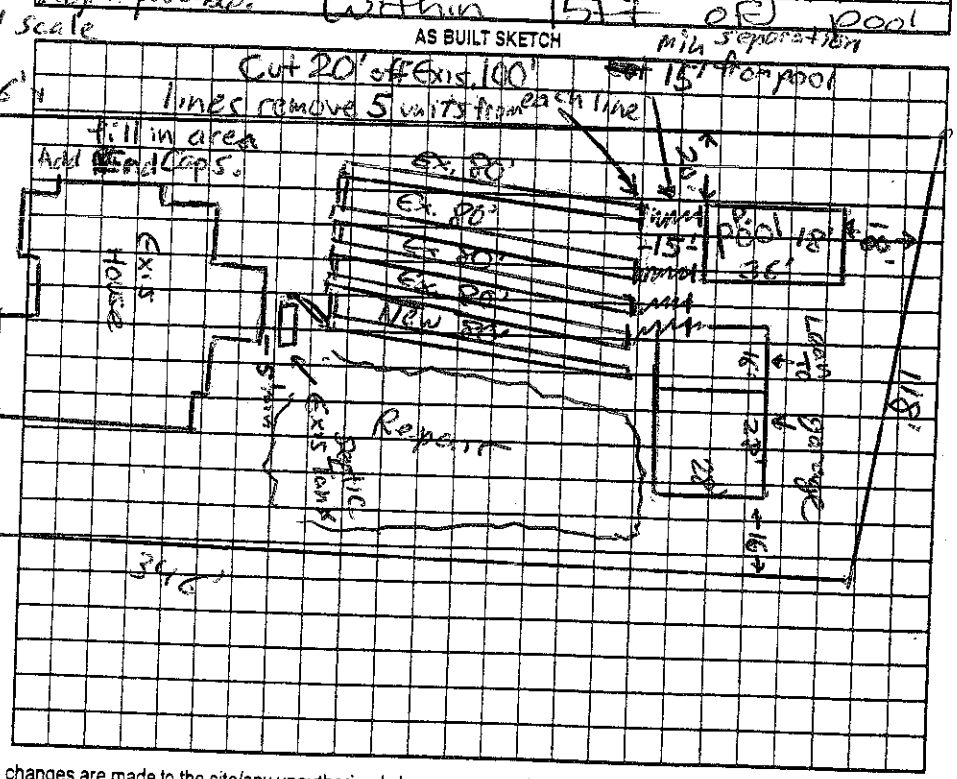

Permit can be suspended or revoked if any false information is supplied toward securing the permit/any unauthorized changes are made to the site/any unauthorized changes are made in the installation of the system. Improvement Permit with plat valid without expiration ☐ Improvement Permit with site plan valid for sixty months ☑ Authorization to Construct is valid for a period equal to that of Improvement Permit – not to exceed sixty months.

Signed: D Wright date 8-20-08

Improvement Permit by: Anthony Cohen RS date 8/19/08

Authorization to Construct by: Anthony Cohen RS date 8/19/08

Installed by: Richard Abernathy

Operation Permit by: Maria Tolson date 9/15/08

Existing System Inspection by: ____ date ____

HEALTH DEPT. COPY: WHITE OWNER COPY (FINAL): YELLOW OWNER COPY (INITIAL): PINK