Existing System ques Ø

IREDELL COUNTY HEALTH DEPARTMENT

STATESVILLE 704-878-5305 MOORESVILLE 704-664-5281

IMPROVEMENT PERMIT / AUTHORIZATION TO CONSTRUCT / OPERATION PERMIT / EXISTING SYSTEM INSPECTION

PERMIT # 154073 PIN # 4636530200.000 DATE 12/9/08

OWNER or APPLICANT David & Emily Wright PHONE: Business 704 662-4432 Home: 704 660 7543

OWNER or APPLICANT ADDRESS 128 Poinsettia Ln. Mooresville NC 28117

LOCATION / DIRECTIONS Brawley Sch Rd. TL on Stutts Rd TR on Poinsettia 3rd house on Right

SUBDIVISION Stutts Cove BLOCK / SECTION 2 LOT # 50 LOT AREA ±.8acre DESIGN FLOW N/A L.T.A.R. N/A

Septic Tank Ex.s 1000 Gallons: STB ____ Date ____

Pump Tank ____ Gallons: P T ____ Date ____

Pump Make ____ Model ____ Serial # ____

Nitrification Field No Fields ____ No Lines ____ Linear Feet ____

Trench Width ____ Max. Trench Bottom Depth ____ Gravel Depth ____

☐ New System ☐ Repair ☐ Expansion System Type I II III IV V VI

System Description: Existing System

Repair System Description: ____

Maintenance Agreement Required ☐ YES ☐ NO

☐ GRAVITY ☐ PRESSURE

☑ Residence No. Bedrooms ____ ☐ Business No. Persons ____ ☑ Other No. Employees ____

☑ Slab ☐ Crawl Space ☐ Basement w/plumbing ☐ Basement w/o plumbing


Water Supply: ☑ Private Ex.s ☐ Public ☐ Community

Comments / Conditions See permit 151956 David Wright 2008


Comments / Conditions Connect Plumbing from Bathroom addition to Existing Septic Tank. *If a grinder pump will be used the pumped line must discharge laterally into 4" gravity line not less than 10' from the connection to the tank through a lateral wye branch. *All plumbing Codes must be followed

INITIAL SITE SKETCH

Scale 1:50

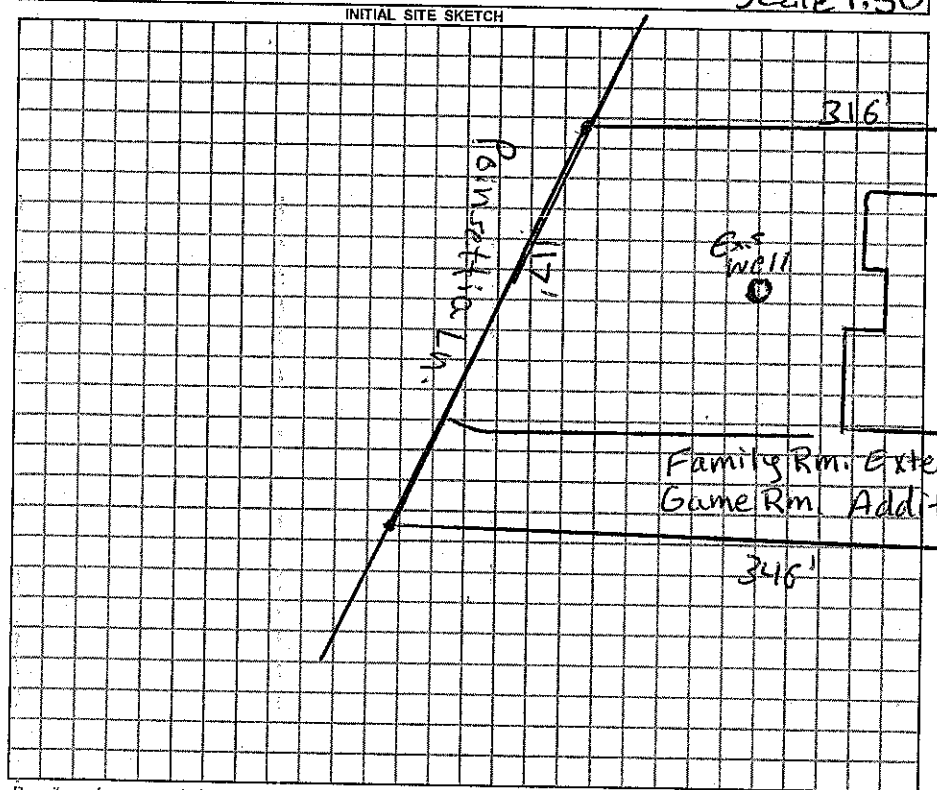

AS BUILT SKETCH

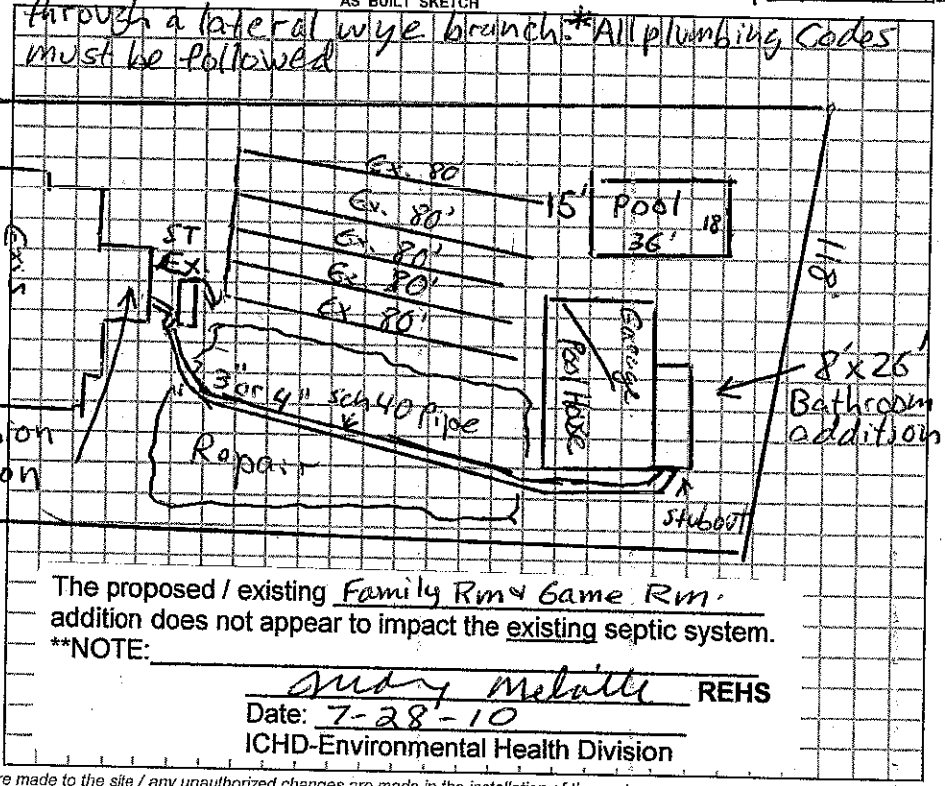

The proposed / existing Family Rm & Game Rm. addition does not appear to impact the existing septic system.

**NOTE: ____

Judy Melville REHS

Date: 7-28-10

ICHD-Environmental Health Division

Permit can be suspended or revoked if any false information is supplied toward securing the permit / any unauthorized changes are made to the site / any unauthorized changes are made in the installation of the system.

☐ IMPROVEMENT PERMIT w / plat valid without expiration. ☐ IMPROVEMENT PERMIT w / site plan valid for 60 mos. ☐ AUTHORIZATION TO CONSTRUCT valid for period equal to IMPROVEMENT PERMIT-not to exceed 60 mo.

Owner / Applicant Signature: [signature] Date 12-10-08

Improvement Permit by: ____ Date ____

Authorization to Construct by: ____ Date ____

YOU SHOULD CONTACT A LOCATOR SERVICE PRIOR TO ANY EXCAVATION.

Installed by: ____

Operation Permit by: ____ Date: ____

Existing System Inspected by: Anthony Coker Jr. R.S. Date: 12/9/08

WHITE COPY Environmental Health YELLOW COPY (Final) Owner / Applicant PINK COPY (Initial) Owner / Applicant