IREDELL COUNTY HEALTH DEPARTMENT

Statesville Office (704) 878-5305 Mooresville Office (704) 660-3625 PERMIT # 180830

IMPROVEMENT PERMIT / AUTHORIZATION TO CONSTRUCT / OPERATION PERMIT / EXISTING SYSTEM

PIN # 4636533433-43

APPLICANT: TQ Custom Const. APPLICANT ADDRESS: 840 Edminston Rd. Mt. Ulla, NC 28125

SITE ADDRESS: 304 Stutts Rd. Mooresville, NC 28117 PHONE: 704 724-3111 ALT. PHONE: Mike 803 802 4402

SITE DIRECTIONS: Brawley School Rd TC Stutts on Rt after Turbyfill

SUBDIVISION: Stutts Cove SECTION: I LOT # 45 LOT AREA: .71 Acre DESIGN FLOW: 480 gpd L.T.A.R.: .3

Septic Tank 1000 (gal) STB 825 Date 2-17-14
Pump Tank (gal) PT Date
Pump Make Model Serial #
Nitrification Fields 1 # Lines 4 Linear Ft: 460
Trench Width 36" Max. Trench Bottom Depth 36" Gravel Depth N/A

☒ New System ☐ Repair ☐ Expansion System Type: I II (III) IV V VI
System Description: Gravity - 25% Reduction
Repair System Description: LPPBPS
Maintenance Agreement Required: ☐ YES ☒ NO
☒ GRAVITY ☐ PRESSURE

☒ Residence ☐ Business ☐ Other ☐ Slab ☒ Crawl Space ☐ Basement w/plumbing ☐ Basement w/o plumbing
No. Bedrooms 4 No. Persons 8 No. Employees
Water Supply: ☒ Private ☐ Public ☐ Community

Comments / Conditions:

INITIAL SITE SKETCH

See Revised Plan (Submitted 2-26-14) from Michael Athanas & Assoc

AS BUILT SKETCH

Permit can be suspended or revoked if any false information is supplied toward securing the permit / any unauthorized changes are made to the site / any unauthorized changes are made in the installation of the system. **CONTACT A LOCATOR SERVICE PRIOR TO ANY EXCAVATION**

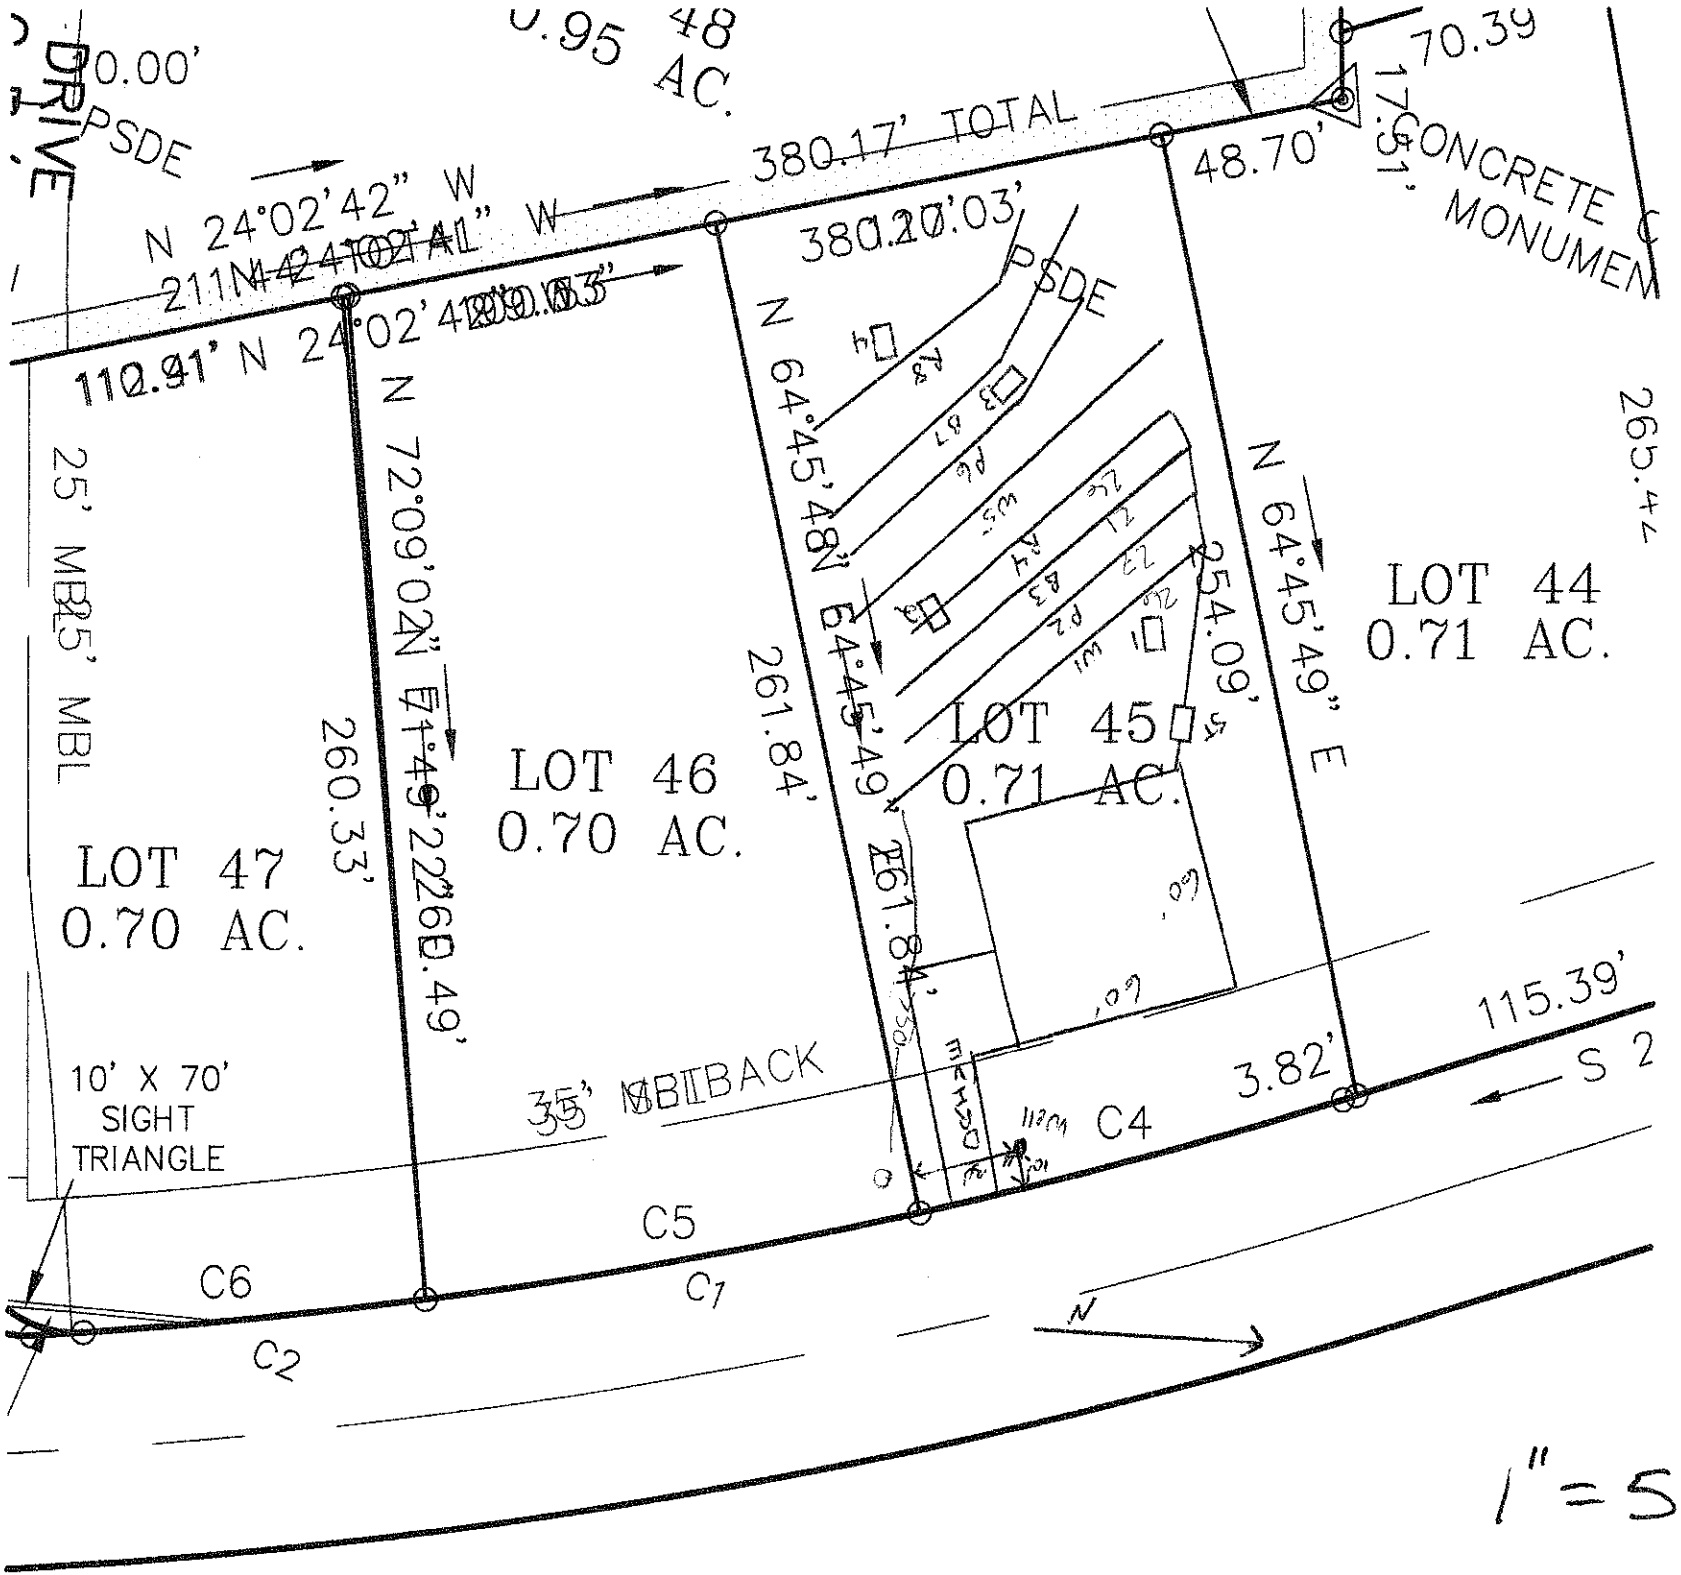
☐ **IMPROVEMENT PERMIT** *with plat valid without expiration.* ☐ **IMPROVEMENT PERMIT** *with site plan valid for 60 mos.* ☐ **AUTHORIZATION TO CONSTRUCT** *valid for period equal to IMPROVEMENT PERMIT--not to exceed 60 mo.*

Owner / Applicant Signature: Date: 3/10/14 Installed by: Rowan Septic

IMPROVEMENT PERMIT by: Michael Athanas RS Date: 3/5/14 OPERATION PERMIT by: Date:

AUTHORIZATION TO CONSTRUCT by: Michael Athanas RS Date: 3/5/14 Existing System Inspected by: Date:

Health Dept. Copy - WHITE Applicant (Final Approval) - YELLOW Applicant (Conditional Approval) - PINK


0.95 AC.
48
70.39
17.51' CONCRETE MONUMENT
48.70'
380.17' TOTAL
380.20'03"
N 24°02'42" W
211.41'
110.91'
N 24°02'42" W
N 64°45'48" E
N 64°45'49" E
265.44'
254.09'
261.84'
261.84'
260.33'
N 72°09'02" E 260.49'
25' MBL
LOT 47
0.70 AC.
LOT 46
0.70 AC.
LOT 45
0.71 AC.
LOT 44
0.71 AC.
10' X 70'
SIGHT
TRIANGLE
35' MBL
BACK
115.39'
3.82'
S 2
C1
C2
C4
C5
C6
N

1" = 50'