11:30

# IREDELL COUNTY HEALTH DEPARTMENT

STATESVILLE 704-878-5305 MOORESVILLE 704-664-5281

## IMPROVEMENT PERMIT / AUTHORIZATION TO CONSTRUCT / OPERATION PERMIT / EXISTING SYSTEM INSPECTION

PERMIT# 075 ~~93374~~ PIN# ~~4636307807 PT~~ 4636535025 DATE 12/3/98

OWNER OR CONTRACTOR M J Fox & Assoc. PHONE: Business 588-3763 Home

ADDRESS 8537 S. Tryon St. Charlotte NC 28273

LOCATION Brawley School Rd N to Stutts Corner of ~~Old Pine Dr~~ Stutts past Turkey Fill

SUBDIVISION Stutts Cove BLOCK / SECTION LOT 8 LOT AREA .93 Acre SITE CLASS. DESIGN FLOW L.T.A.R.

Septic Tank: 1000 Gallons; STB 1012 Date 3/22/99
Pump Tank: Gallons; PT Date
Pump Make: Model Serial No.
Nitrification Field: No Fields 1 Square Feet 1200' Linear Feet 400'
No Lines 4 at 100' Trench Width 36" Max Trench Bottom Depth 24" Gravel Depth 12"

☒ New System ☐ Repair System Type: I, II, III, IV, V, VI
System Description: Gravity - Conventional
Repair System Description: Gravity/Pump Modified
Maintenance Agreement Required: ☐ Yes ☐ No


☒ House/Mod. Home No. Bedrooms 3
☐ Mobile Home No. Bathrooms 2
☐ Business No. Employees
☐ Other
☐ Slab ☒ Crawl Space ☐ Basement w/plumbing ☐ Basement wo/plumbing

Water Supply: ☒ Individual ☐ Public ☐ Community

Comments:/Conditions: Keep Septic System at least 10' from PL, 5' From House & at least 50' from well.

Comments:/Conditions: POINSETTA DR NEW STREET NAME

**INITIAL SITE SKETCH** Scale 1:50

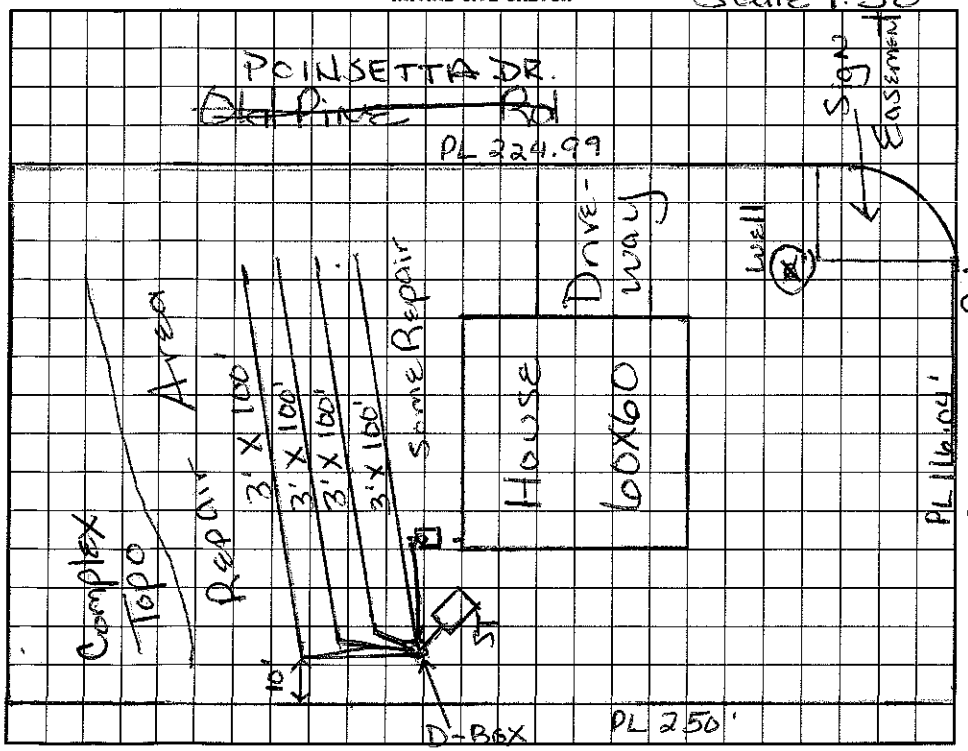


**AS BUILT SKETCH**

I understand that this permit can be suspended or revoked if any false information is supplied toward securing the permit/any unauthorized changes are made to the site/any unauthorized changes are made in the installation of the system. Improvement Permit with plat valid without expiration. Improvement Permit with site plan valid for sixty months. Authorization to Construct is valid for a period equal to that of Improvement Permit – not to exceed sixty months.

Signed: L. Odom date 12/3/98 Installed by: Abernethy

Improvement Permit by: Maria H. Eaton RS. date 12/3/98 Operation Permit by: Wesley Sparks RS. date 5/3/99

Authorization to Construct by: Maria H. Eaton date Existing System Inspection by: date

HEALTH DEPT. COPY: WHITE INSPECTION COPY (FINAL): GREEN OWNER COPY (FINAL): YELLOW INSPECTION COPY (INITIAL): PINK OWNER COPY (INITIAL): GOLD