IREDELL COUNTY HEALTH DEPARTMENT

STATESVILLE 704-878-5305 MOORESVILLE 704-664-5281

IMPROVEM...T PERMIT / AUTHORIZATION TO CONSTRUCT / OPERATION PERMIT / EXISTING SYSTEM INSPECTION

PERMIT# 135880 PIN# 4636548686 DATE 6-8-06

OWNER OR APPLICANT The Hoke Company PHONE: Business 704-799-7495 Home 704-7992657

ADDRESS PO Box 4448 mooresville

LOCATION Brawley School Rd TL Mallard Way at end on right (320 Mallard Way)

SUBDIVISION Mallard Head C.C. BLOCK / SECTION ____ LOT 180 LOT AREA .17 Ac SITE CLASS. PS DESIGN FLOW ____ L.T.A.R. .3

Septic Tank: 1000 Gallons; STB 312 Date 3-24-06
Pump Tank: 1000 Gallons; PT 27 Date ____
Pump Make: Myers Model ME50S-21 Serial No. ____
Nitrification Field: No Fields ____ Square Feet ____ Linear Feet ____
No Lines ____ Trench Width ____ Max Trench Bottom Depth ____ Gravel Depth ____

☐ New System ☐ Repair ☐ Expansion System Type: I II III (IV) V VI
System Description: Existing LP PPBPS
Repair System Description: LP PPBPS max. feasible
Maintenance Agreement Required: ☒ Yes ☐ No

☒ House/Mod. Home ☐ Mobile Home ☐ Business ☐ Other
No. Bedrooms 4 No. Persons 8 No. Employees ____

Water Supply: ☐ Individual ☐ Public ☒ Community


☐ Gravity ☒ Pressure ☐ Slab ☒ Crawl Space ☐ Basement w/plumbing ☐ Basement wo/plumbing

½ HP


Comments:/Conditions: Set new septic & pump tanks and supply line to existing valves & set pressure for existing 4 lines, submit Maintenance Plan Remove fill from repair area

Comments:/Conditions: Plat Book 16 Page 53 - 1980
12-19-06 No date on PT
1-29-07 Tank set 30 days

INITIAL SITE SKETCH

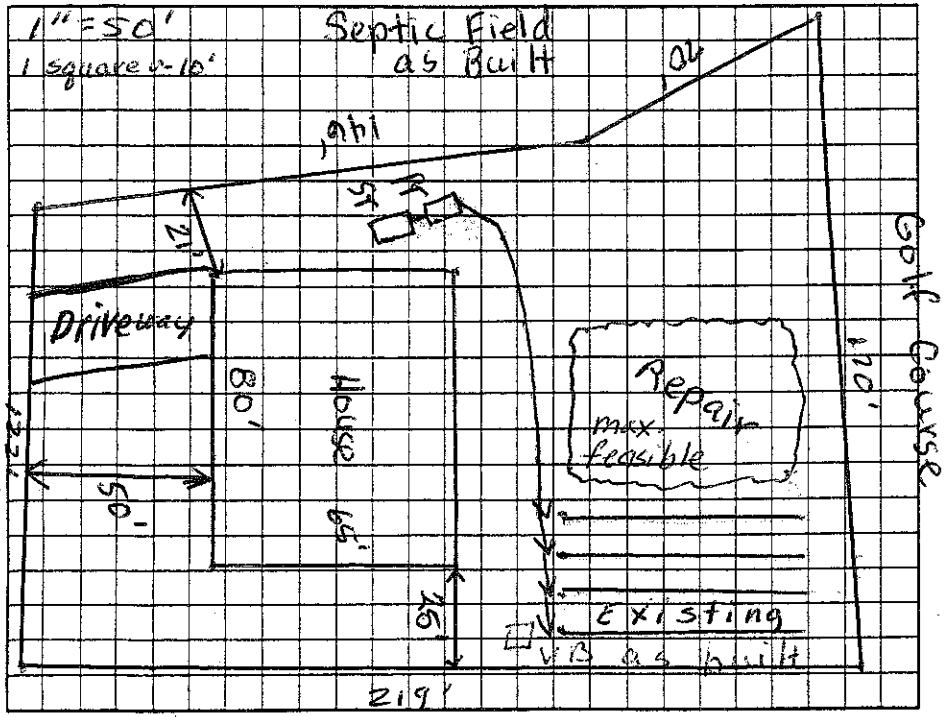

AS BUILT SKETCH

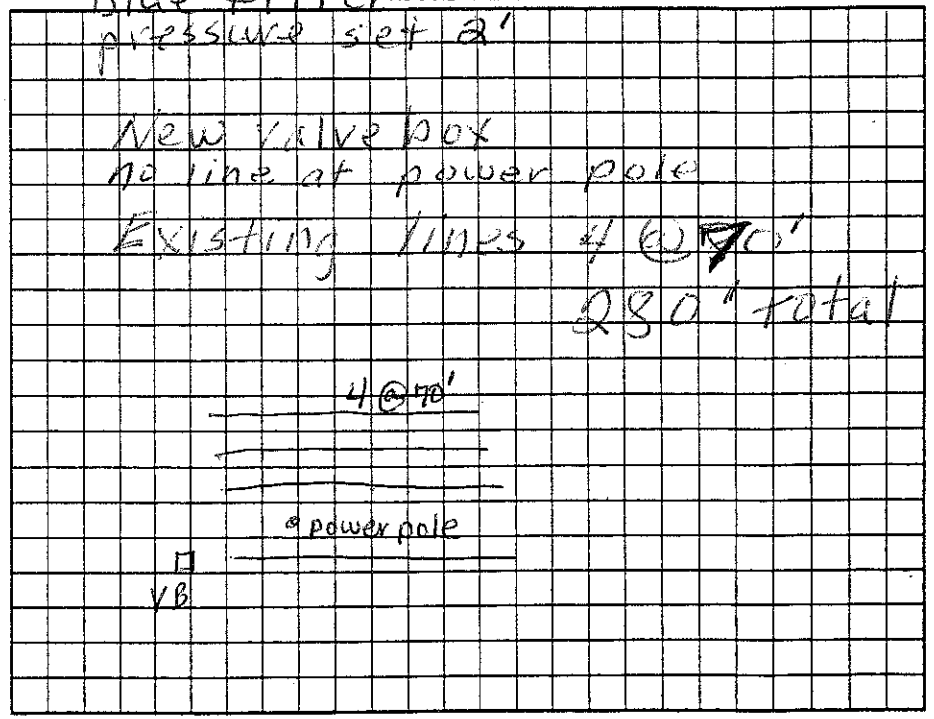

Permit can be suspended or revoked if any false information is supplied toward securing the permit/any unauthorized changes are made to the site/any unauthorized changes are made in the installation of the system. Improvement Permit with plat valid without expiration ☐ Improvement Permit with site plan valid for sixty months ☒ Authorization to Construct is valid for a period equal to that of Improvement Permit – not to exceed sixty months.

Signed: David Hoke date 6/8/06
Improvement Permit by: Judy Melville date 6-8-06
Authorization to Construct by: Judy Melville date 6-8-06

Installed by: R + H
Operation Permit by: Judy Melville date 1-29-07
Existing System Inspection by: ____ date ____

HEALTH DEPT. COPY: WHITE OWNER COPY (FINAL): YELLOW OWNER COPY (INITIAL): PINK