IREDELL COUNTY HEALTH DEPARTMENT

STATESVILLE 704-878-5305 MOORESVILLE 704-664-5281

IMPROVEMENT PERMIT / CERTIFICATE OF COMPLETION / OPERATION PERMIT / EXISTING SYSTEM INSPECTIO

PROPERTY DESCRIPTION NO. 18116 DATE June 20, 194 TAX MAP NO. 2K12A179

OWNER OR CONTRACTOR Kim Duggins ~~PHONE: Business~~ 4636-54-9904 Home Watershed: ☐ Yes ☐ No

ADDRESS PO Box 399 Ft Mt Mourne

LOCATION 1100 Tr Mallard Way past Club House near end on Right n 200' off Street

SUBDIVISION Mallard Head BLOCK / SECTION LOT 179 LOT AREA SITE CLASS. DESIGN FLOW 480gpd L.T.A.R. .03

Septic Tank: (2) 1000 Gallons; STB 794 Date 12-12-94

Pump Tank: Vault 1050 ST Gallons; STB 794 Date 12-12-94

Pump Make: Model Serial No.

Nitrification Field: No Fields 2 Square Feet 1200+450 Linear Feet 400+150

No Lines 7+2 Trench Width 36" Max Trench Bottom Depth 36" Gravel Depth 12"

☑ New System ☐ Repair System Type: I, II, III, IV, V, VI

System Description: gravity conventional

Repair System Description: PABPS

Maintenance Agreement Required: ☐ Yes ☑ No

☑ House/Mod. Home No. Bedrooms 4

☐ Mobile Home No. Bathrooms 3½

☐ Business No. Employees

☐ Other


☐ Slab ☐ Crawl Space ☑ Basement w/plumbing ☐ Basement wo/plumbing

Water Supply: ☑ Individual ☐ Community ☐ Public


Comments Exit may be level plumbing at garage corner as shown, site at a level to accomodate specified trench bottom depth.

Comments:

INITIAL SITE SKETCH

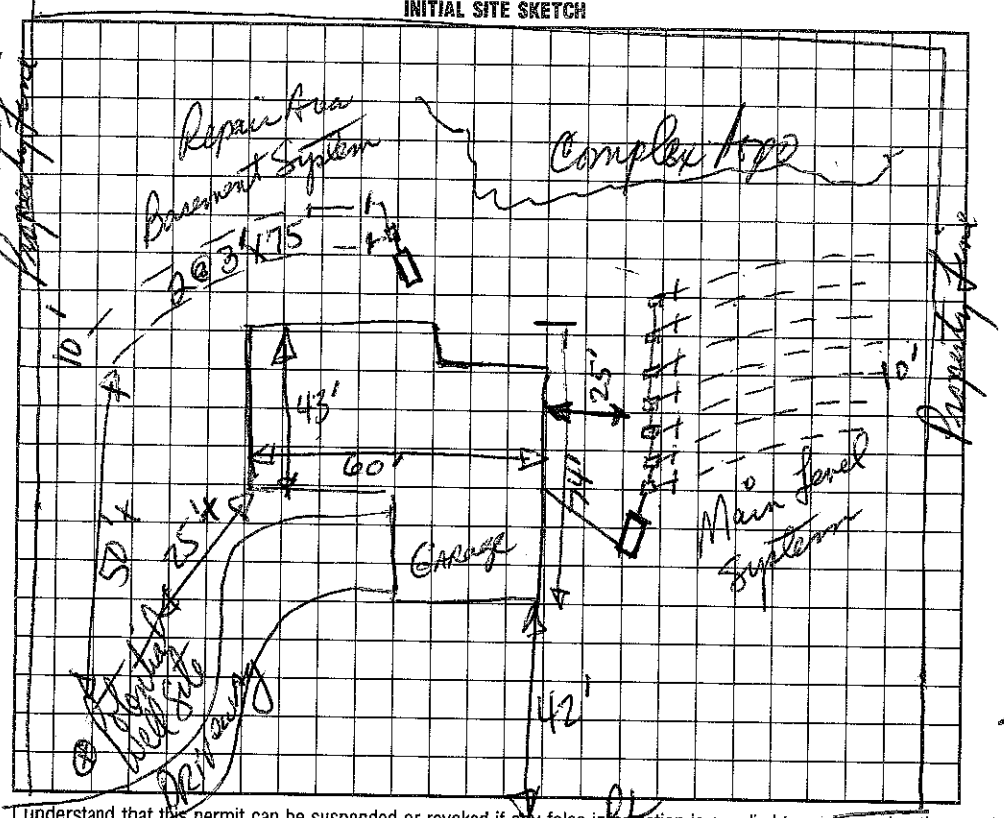

AS BUILT SKETCH

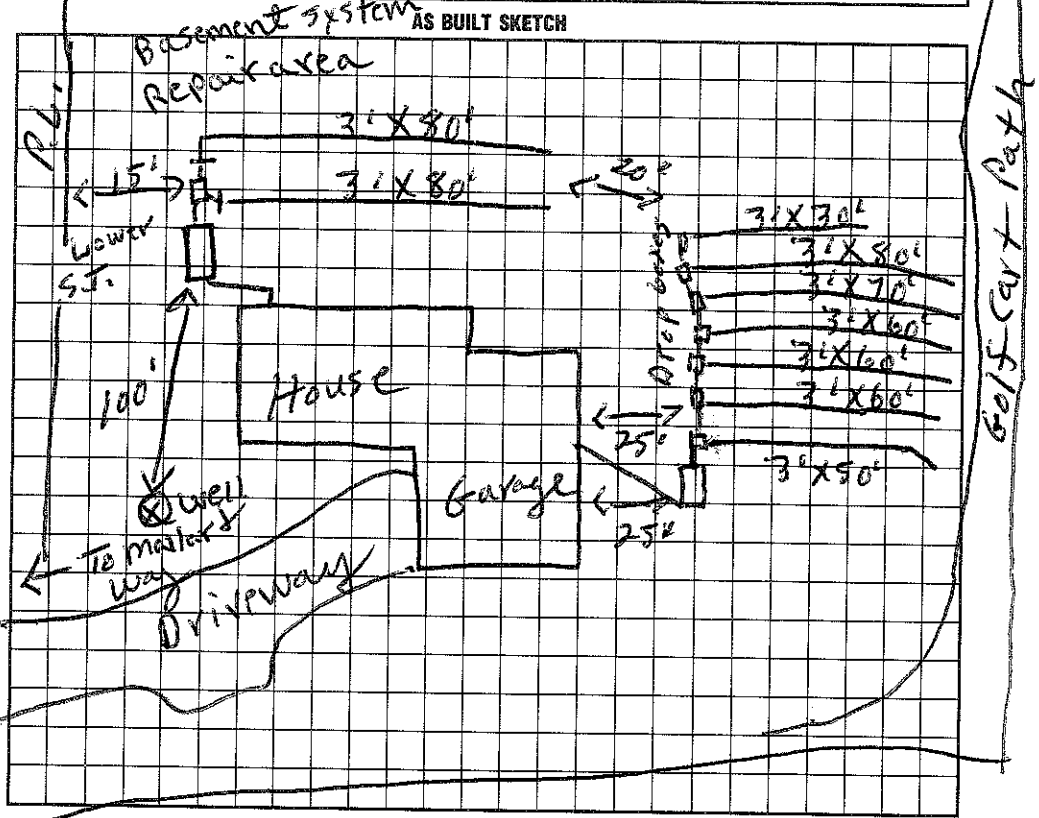

I understand that this permit can be suspended or revoked if any false information is supplied toward securing the permit/any unauthorized changes are made to the site/any unauthorized changes are made in the installation of the system. Improvement Permit is valid for 60 months from date of issuance.

Signed:

Improvement Permit by: date 6/20/94

Existing System Inspection by: date

Installed by: Cornelius Grating

Certificate of Completion by: J. C. Moore date 4-10-95

Operation Permit by: date

HEALTH DEPT. COPY: WHITE INSPECTION COPY (FINAL): GREEN OWNER COPY (FINAL): YELLOW INSPECTION COPY (INITIAL): PINK OWNER COPY (INITIAL): GOLD