IREDELL COUNTY HEALTH DEPARTMENT

STATESVILLE 704-878-5305 Paid 325.00 MOORESVILLE 704-664-5281

IMPROVEMENT PERMIT / AUTHORIZATION TO CONSTRUCT / OPERATION PERMIT / EXISTING SYSTEM INSPECTION

PERMIT# 078706 PIN# 4636 56 3833 DATE 6/19/00

OWNER OR CONTRACTOR Ray Sprott PHONE: Business 664-6761 Home

ADDRESS 470 Stutts Rd. Mooresville, NC.

LOCATION 1100, TL Cool Breeze TR Overlook on (R) of cul de sac

SUBDIVISION PONDLANE BLOCK / SECTION LOT 9 LOT AREA .62 SITE CLASS PS DESIGN FLOW 360 L.T.A.R. .3

Septic Tank: 1000 Gallons; STB 312 Date 1/1/01
Pump Tank: 1000 Gallons; PT 283 Date 1/23/01
Pump Make: GOULDS Model WE03J1M Serial No. K0042830
Nitrification Field: No Fields 1 Square Feet 600± Linear Feet 200
No Lines 4@50' Trench Width 36" Max Trench Bottom Depth 36" Gravel Depth SAND

[X] New System [ ] Repair System Type: I, II, III, IV, V, VI
System Description: LPP - 16" PP35
Repair System Description: SAME
Maintenance Agreement Required: [X] Yes [ ] No

[X] House/Mod. Home No. Bedrooms 3
[ ] Mobile Home No. Bathrooms 3
[ ] Business No. Employees
[ ] Other


[ ] Slab [X] Crawl Space [ ] Basement w/plumbing [ ] Basement wo/plumbing

Water Supply: [X] Individual [ ] Public [ ] Community

Comments:/Conditions:

(1" = 50')

INITIAL SITE SKETCH

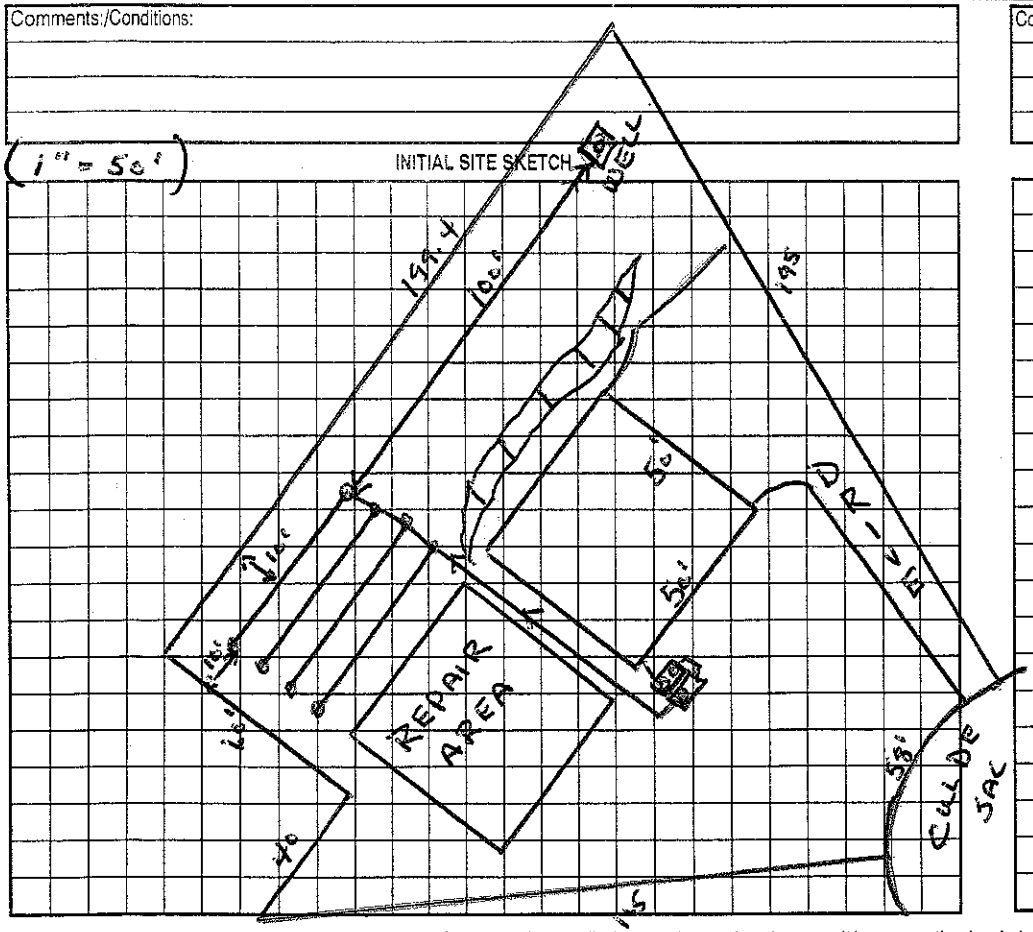

Comments:/Conditions:

AS BUILT SKETCH

Permit can be suspended or revoked if any false information is supplied toward securing the permit/any unauthorized changes are made to the site/any unauthorized changes are made in the installation of the system. Improvement Permit with plat valid without expiration. Improvement Permit with site plan valid for sixty months. Authorization to Construct is valid for a period equal to that of Improvement Permit – not to exceed sixty months.

Signed: [signature] date 7/5/00 Installed by: Tony Fryc

Improvement Permit by: Wesley Sparks R.S. date 6/20/00 Operation Permit by: Wesley Sparks R.S. date 5/2/01

Authorization to Construct by: Wesley Sparks R.S. date 6/20/00 Existing System Inspection by: date

HEALTH DEPT. COPY: WHITE OWNER COPY (FINAL): YELLOW OWNER COPY (INITIAL): PINK