IREDELL COUNTY HEALTH DEPARTMENT

paid 125.00

STATESVILLE 704-878-5305 MOORESVILLE 704-664-5281

IMPROVEMENT PERMIT / AUTHORIZATION TO CONSTRUCT / OPERATION PERMIT / EXISTING SYSTEM INSPECTION

PERMIT# 078707 PIN# 4636-56-4914 DATE 6/29/00

OWNER OR CONTRACTOR Ray Shutt PHONE: Business 664-6761 Home

ADDRESS 470 Stutts Rd. Mooresville NC. 28117

LOCATION 1100 TL Cool Breeze TR Overlook, 3rd lot on (R)

SUBDIVISION Pond Lane BLOCK / SECTION LOT 10 LOT AREA .53 SITE CLASS PS DESIGN FLOW 360 L.T.A.R. .3

Septic Tank: 1000 Gallons; STB 825 Date 10/24/00
Pump Tank: Gallons; PT Date
Pump Make: Model Serial No.
Nitrification Field: No Fields 1 Square Feet 630 Linear Feet 210
No Lines 3@70 Trench Width 36" Max Trench Bottom Depth 36" ~~Gravel Depth~~ SAND.

[X] New System [ ] Repair System Type: I, II, (III), IV, V, VI
System Description: Gravity - 16" PPBS
Repair System Description: Same
Maintenance Agreement Required: [ ] Yes [X] No


[X] House/Mod. Home No. Bedrooms 3
[ ] Mobile Home No. Bathrooms 3
[ ] Business No. Employees
[ ] Other

[ ] Slab [X] Crawl Space [ ] Basement w/plumbing [ ] Basement wo/plumbing

Water Supply: [X] Individual [ ] Public [ ] Community

Comments:/Conditions:

INITIAL SITE SKETCH

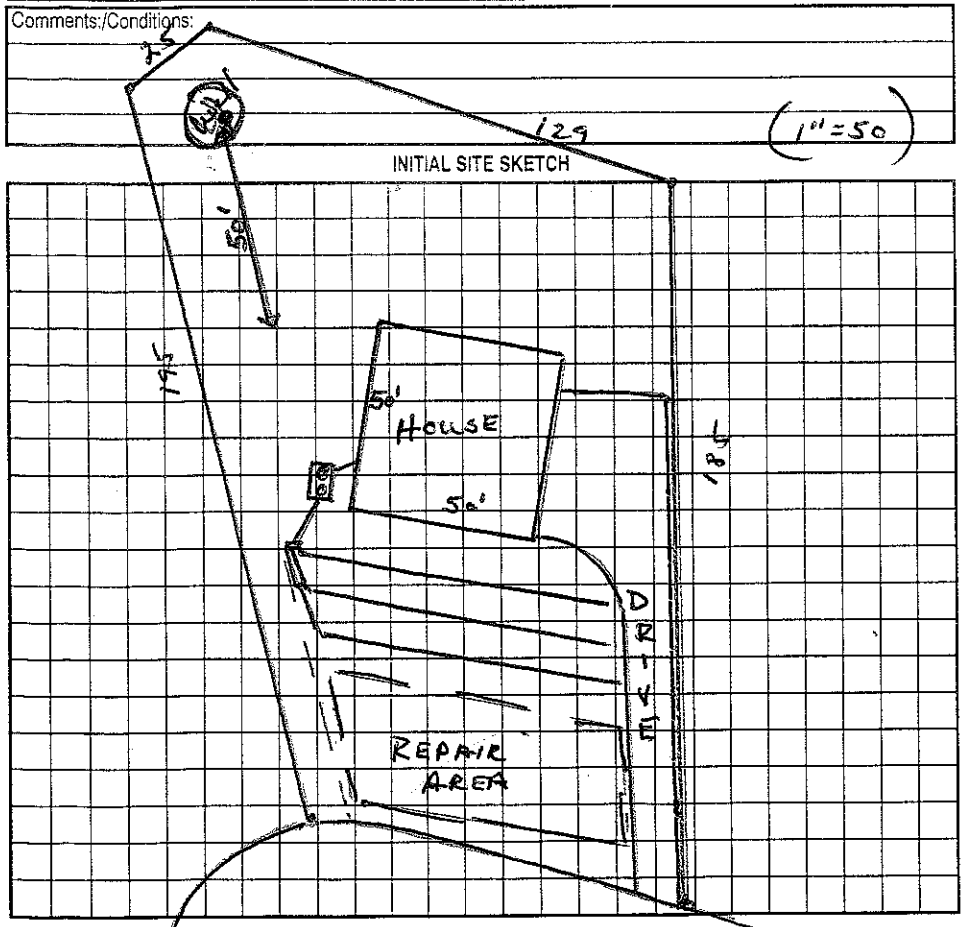

Comments:/Conditions:

AS BUILT SKETCH

Permit can be suspended or revoked if any false information is supplied toward securing the permit/any unauthorized changes are made to the site/any unauthorized changes are made in the installation of the system. Improvement Permit with plat valid without expiration. Improvement Permit with site plan valid for sixty months. Authorization to Construct is valid for a period equal to that of Improvement Permit – not to exceed sixty months.

Signed: R M Shutt date 7/5/00

Improvement Permit by: Wesley Sparks RS. date 6/29/00

Authorization to Construct by: Wesley Sparks RS date 6/29/00

Installed by: Rowan Septic Tank

Operation Permit by: Wesley Sparks date 1/11/01

Existing System Inspection by: date

HEALTH DEPT. COPY: WHITE OWNER COPY (FINAL): YELLOW OWNER COPY (INITIAL): PINK